

SEE

SEE

#21812


COMBINATION

BOONE

BOSTON

COLUMBIA #21812

SCALE: 1" = 400'

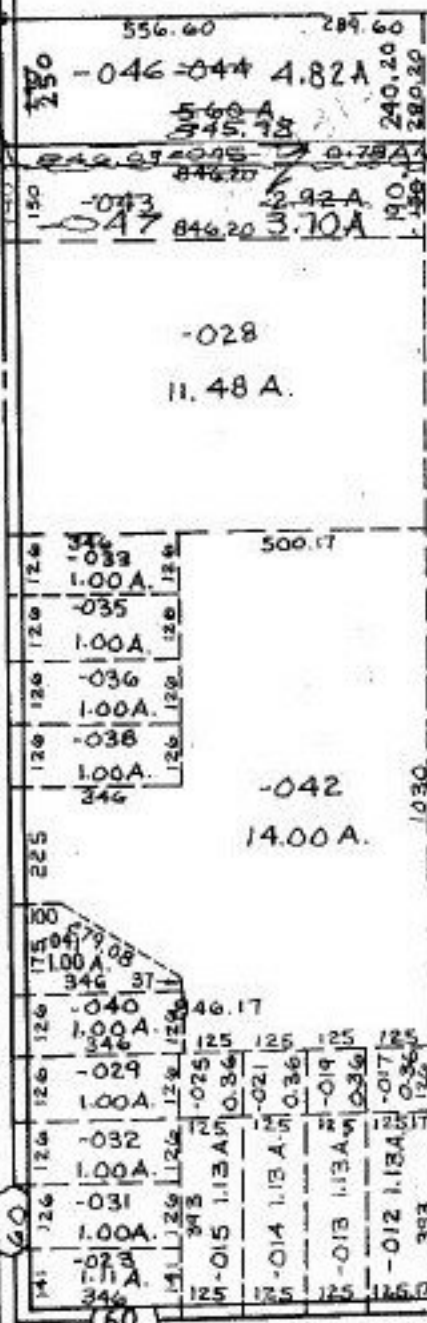

P.P.NO. 12-00-011-000-
 PRIOR INST: (044)DV969/947
 (043)DV. 1281/779
 CLOSURE: 0.02:10,000
 SURVEYED BY: JOHN POZYWAK
 REG. SURVEYOR

21812
 APPROVED
 LORAIN CO
 MAP DEPT
 DATE 7-2-96
 PAGE 12-H
 BY CAROLYN
 FRANCIS

T