


PARENT PARCEL: 08-00-091-000-023

CHILD PARCEL: 08-00-091-000-049 & -050

STARTING POINT: CL OF GIFFORD RD. & CL OF S.R. 113

NO. 21816

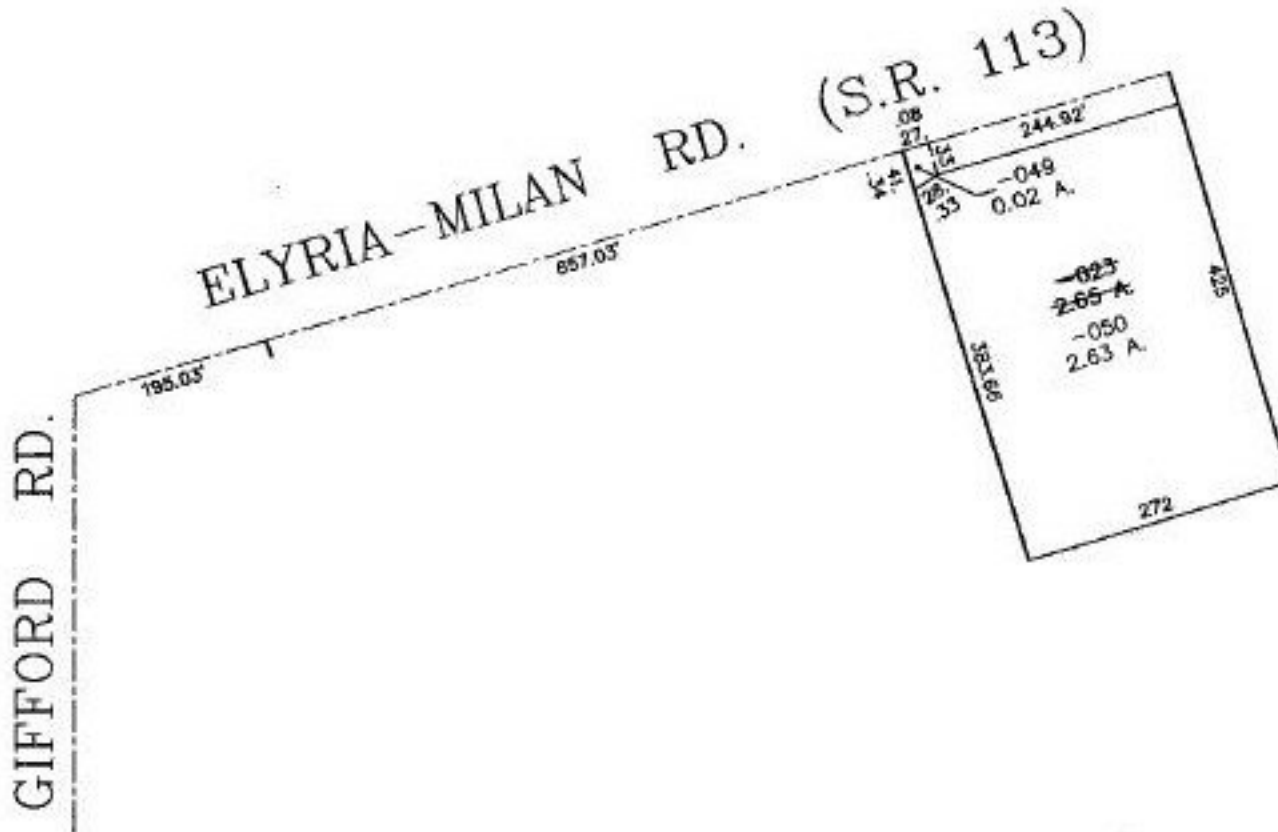

**SPLITS/DEEDS PROCESSED**  
 LORAIN COUNTY TAX MAP DEPARTMENT  
 226 MIDDLE AVE. ELYRIA, OHIO

SURVEYED BY: RONALD D. ROBINSON  
 CLOSURE: 0.01 : 10,000  
 MAP PAGE(S): 8-C  
 APPROVED BY: IJS DATE: 01/05/01  
 SCALE: 1" = 200' PRIOR INSTRUMENT: OR 702/178