


#21821

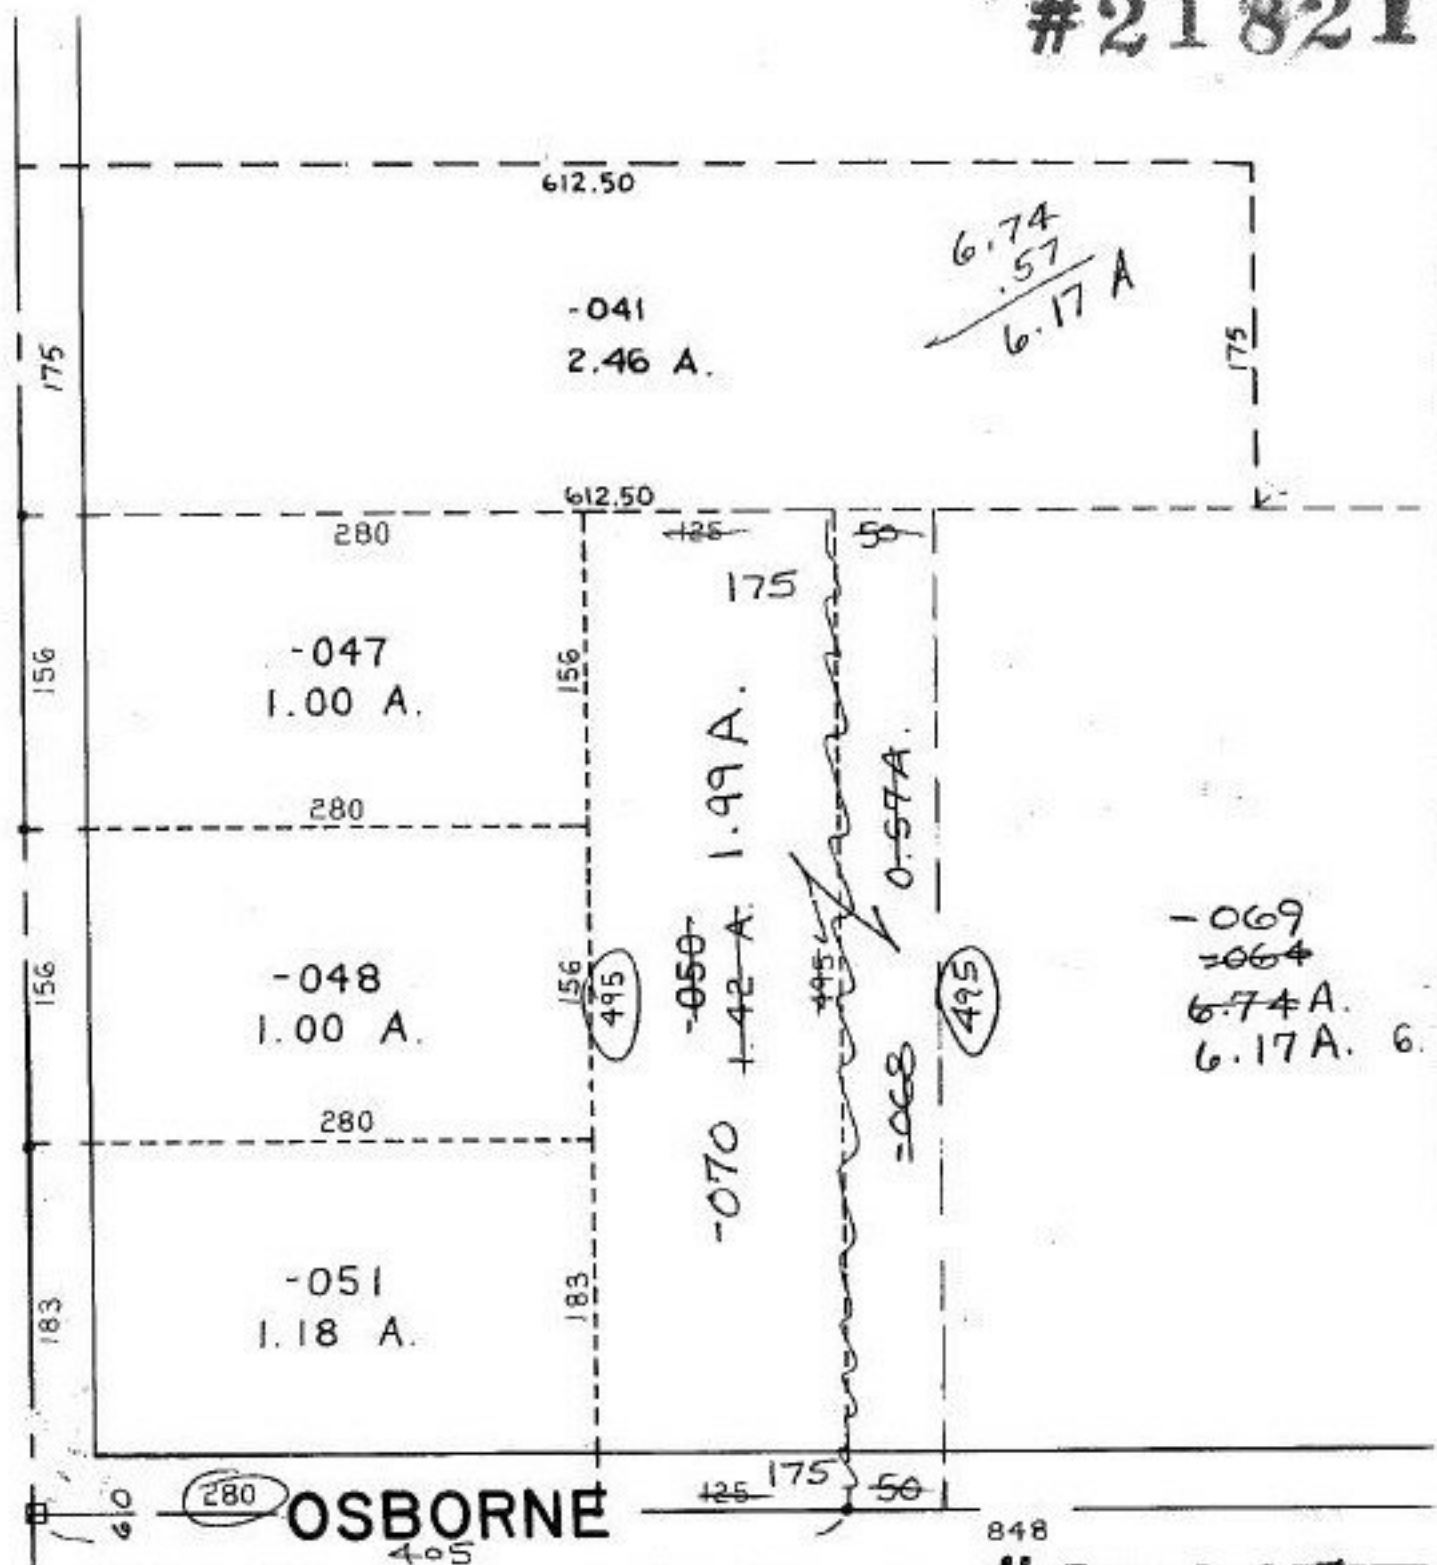

SEE 12-A

SURVEYED By RONALD D. ROBISON
 PRIOR ISS. 1170/160
 CLOSURE 0.00 : 10,000

#21821

APPROVED	
LORAIN CO.	
MAP DEPT.	
DATE 7-12-96	
PAGE 1200-062A	
BY <i>A. Collett</i>	
VOID AFTER	21821