


#21825

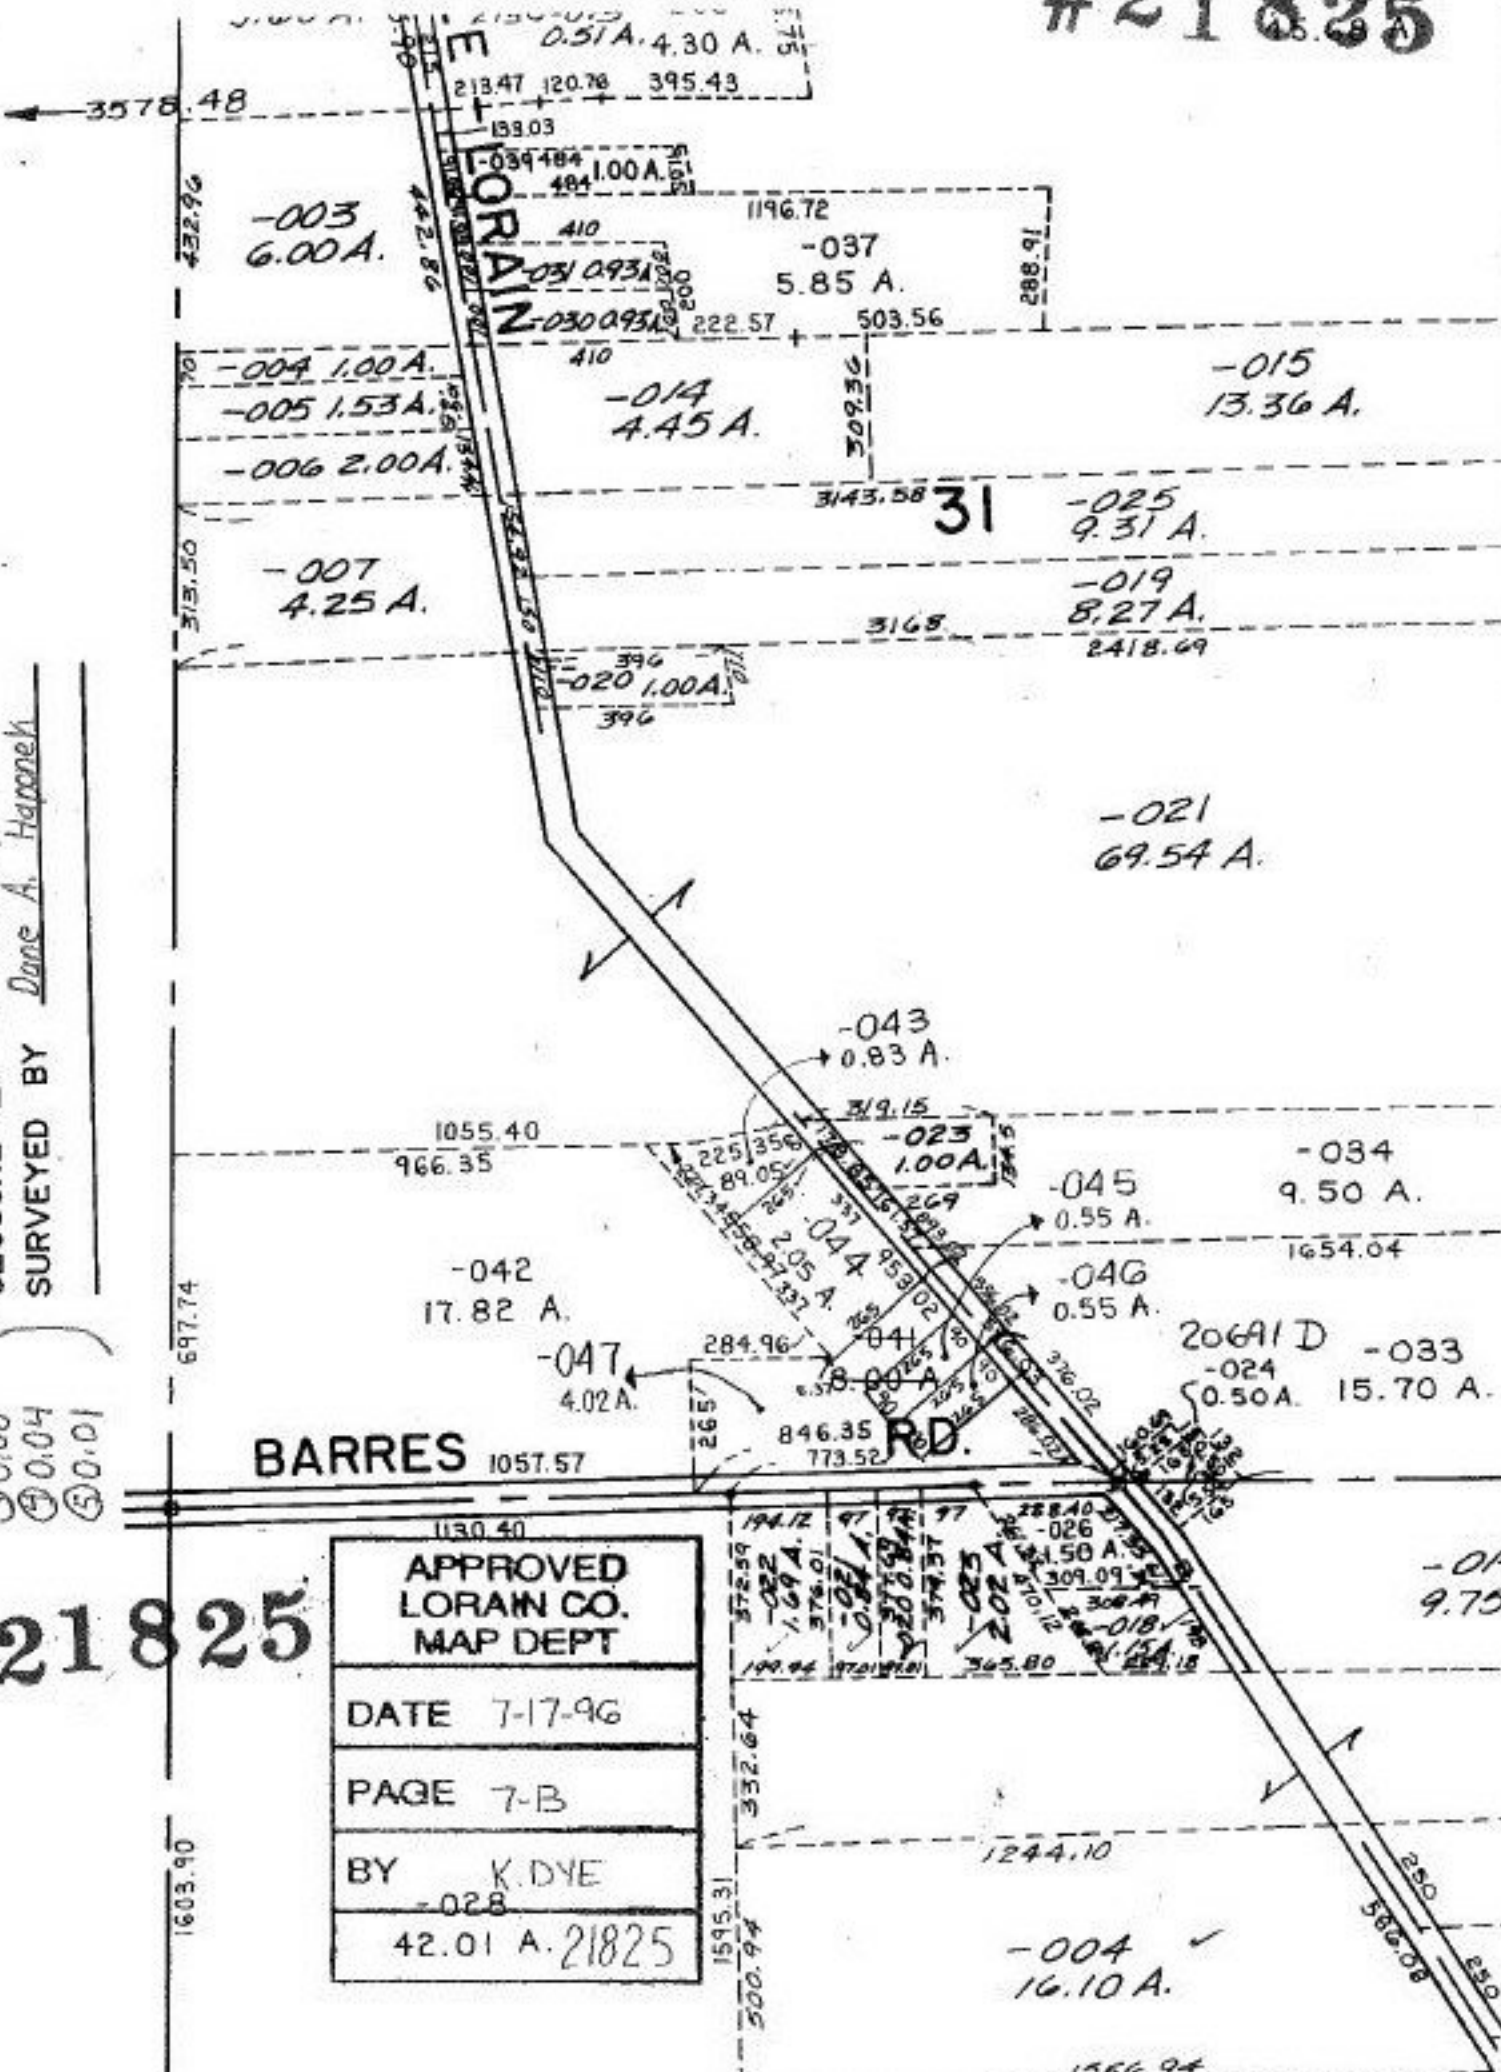

PRIOR INSTRUMENT OR 1053/832
 CLOSURE PER 10,000
 SURVEYED BY Dan A. Hapanek

- ① 0.00
- ② 0.00
- ③ 0.00
- ④ 0.04
- ⑤ 0.01

#21825

APPROVED LORAIN CO. MAP DEPT
DATE 7-17-96
PAGE 7-B
BY K.DYE
-028 42.01 A. 21825

1603.90

1595.31

-004 ✓
16.10 A.

1566.94

-014
9.75

2061 D
-024 0.50 A.
-033 15.70 A.

-034
9.50 A.
1654.04

-045
0.55 A.
-046
0.55 A.

-042
17.82 A.

-047
4.02 A.

846.35
773.52
RD.

BARRES 1057.57

1130.40

1244.10

332.64

372.59

284.96

1055.40
966.35

319.15

3168

3143.58 31

410

410

410

697.74

622.24

3578.48

442.86

442.86

