

#21857


87°36'

655.50  
659.1✓

87°30'

~~Pt. -072~~  
~~Pt. 13.96 A.~~

← 1988.08  
← 1998.48

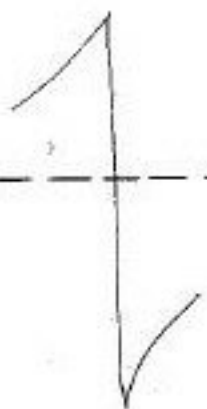

Pt. -080  
Pt. 38.96 A.

~~Pt. -052~~  
~~Pt. 25.00 A.~~

~~550.6~~

950.54

599.74

ADVISED  
# 962-184  
5/16/96

FAITH  
1500(216)  
292-34

21857

APPROVED	
LORAIN CO.	
MAP DEPT.	
DATE	7/26/96
PAGE	15-00-055 B
BY	K. DYE
VOID AFTER	# 21857

PRIOR INSTRUMENT V 328/314  
CLOSURE --- PER 10,000  
SURVEYED BY ---

← 1668.48✓  
← 2671.02

SEE 15-00-06