

~~Pt. 13.96 A.~~

054
.68 A.

200

071 0.18 A.

89°20' 200

1988.08
1998.48

Pt. -080
Pt. 38.96 A.

PRIOR INSTRUMENT V 328/314
CLOSURE — PER 10,000
SURVEYED BY —

~~Pt. -052~~
~~Pt. 25.00 A.~~

-060
1.65 A.

-059
0.85 A.

#21857


21857

APPROVED LORAIN CO. MAP DEPT.	
DATE 7-26-96	
PAGE 1500.055-A	
BY K.DYE	
VOID AFTER	# 21857

#21857

1668.48
2671.02

CENTER

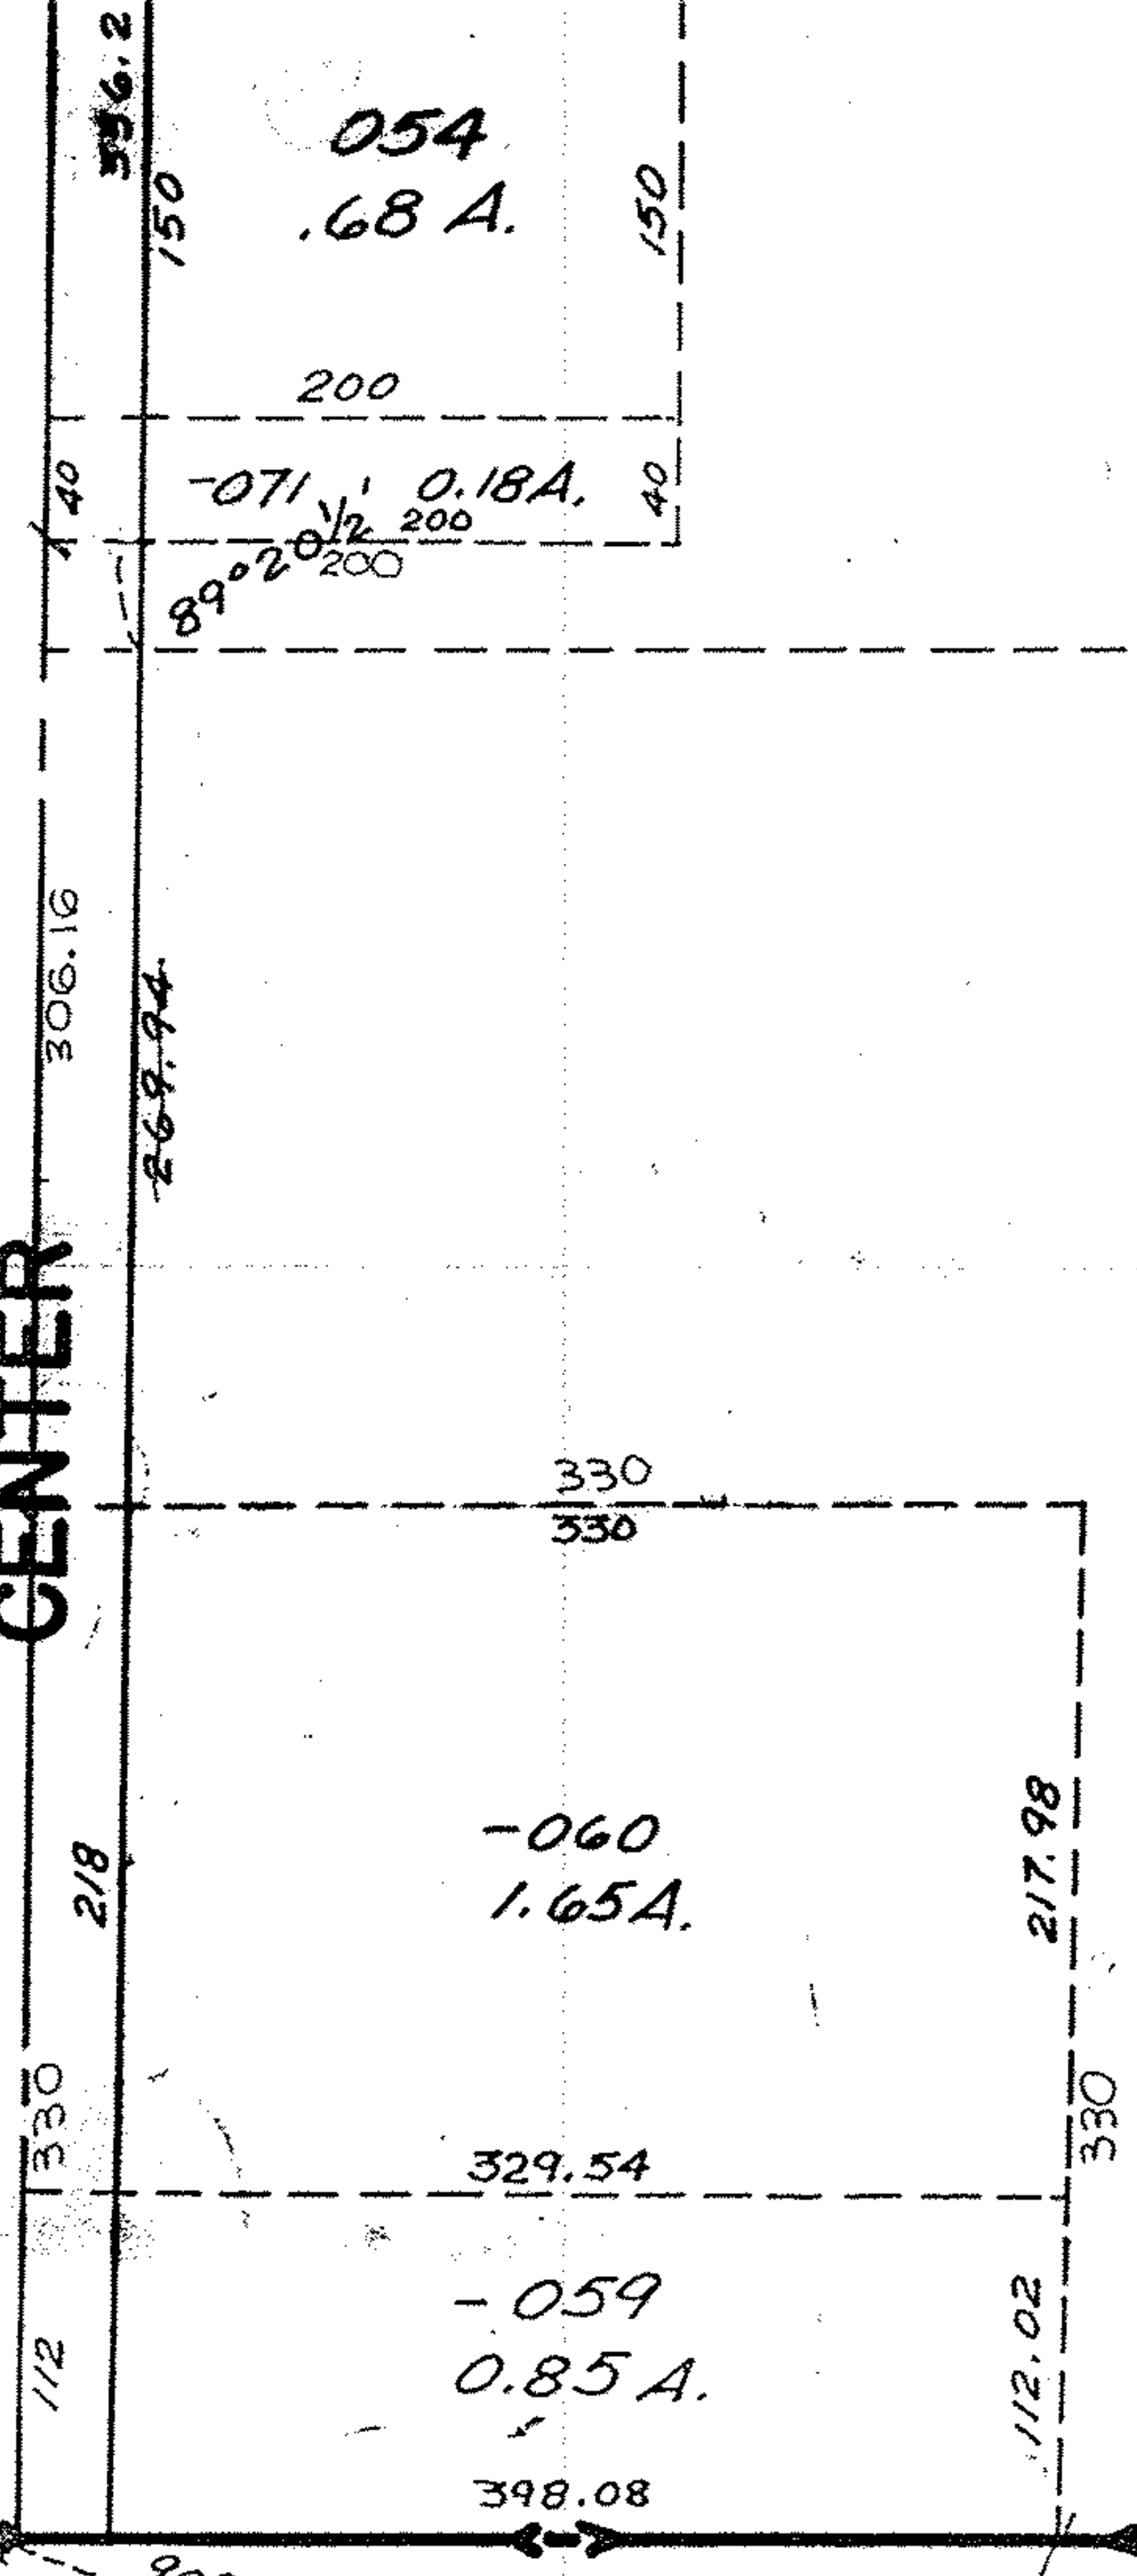

Corp. Line