


#21874

DETAIL
NOT TO SCALE

391.80
455.26
847.06

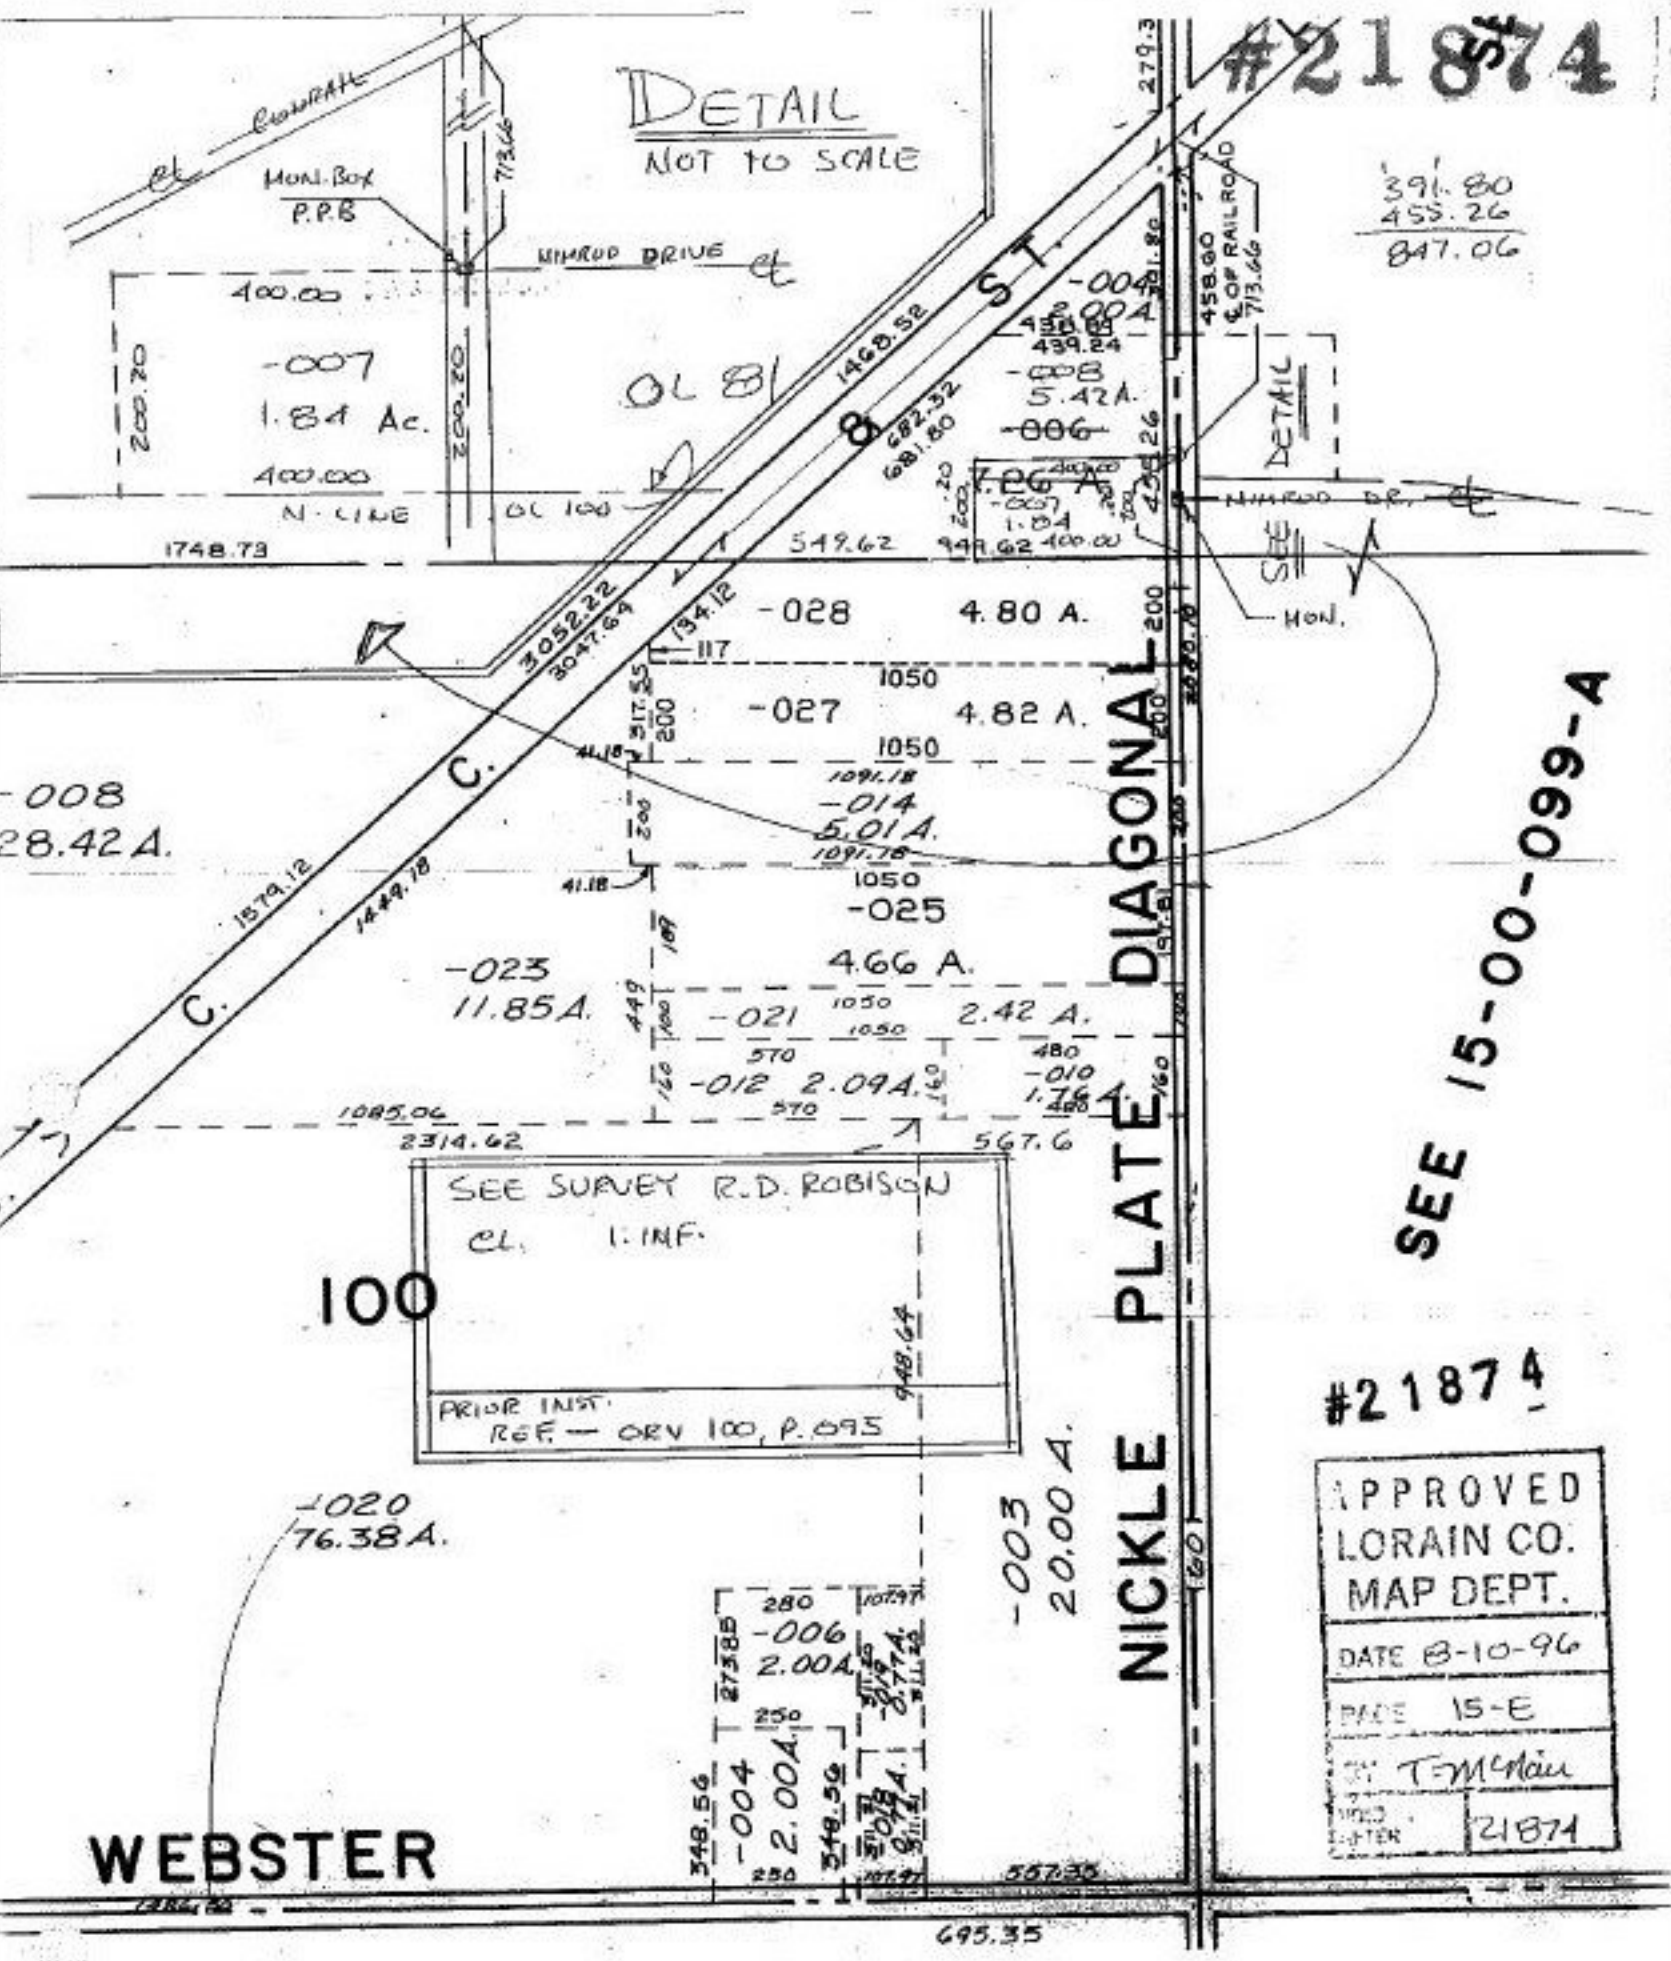

NICKLE PLATE DIAGONAL

SEE 15-00-099-A

#21874

APPROVED
LORAIN CO.
MAP DEPT.
DATE 8-10-96
PAGE 15-E
BY T-McNair
NO. 21874

WEBSTER

LOTS 58 THRU 63, 78 THRU 83, 98 TH