


#21886

303.75
el. INT. MAIN & GLEN

E MAIN ST. & W. LINE OF LAND (OV 972-664)

303

MAIN

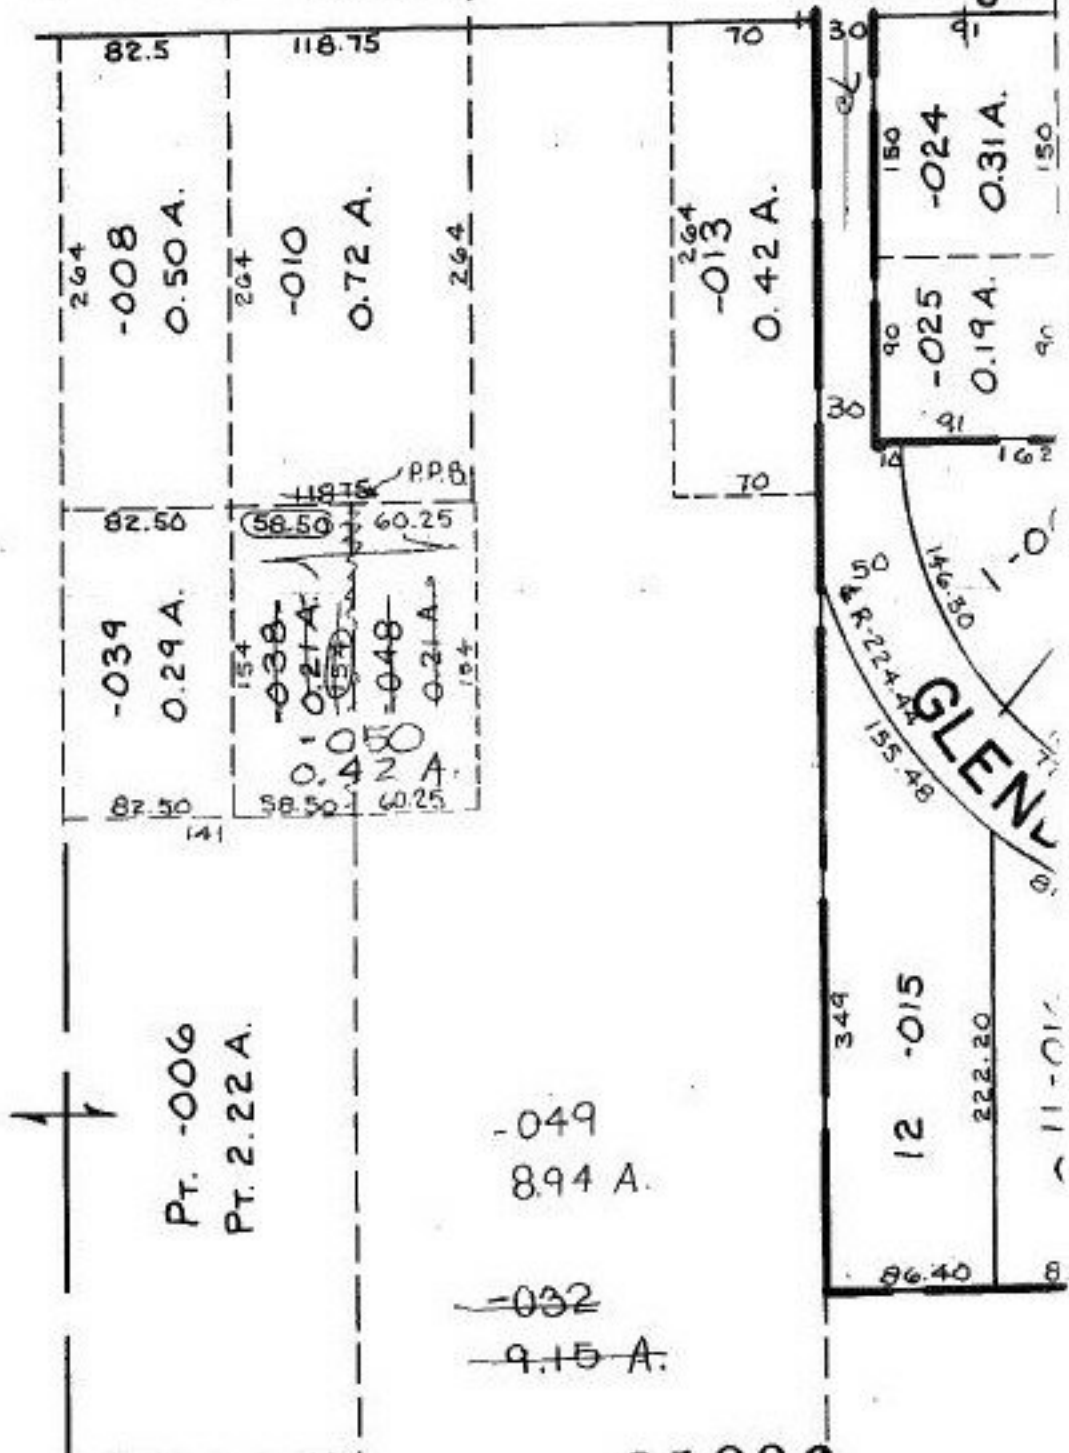

21886

APPROVED
 LORAIN CO.
 MAP DEPT.
 DATE 9-13-96
 PAGE 15-00-056-B
 BY K. DYE
 VOID AFTER # 21886

10