


#21887-A

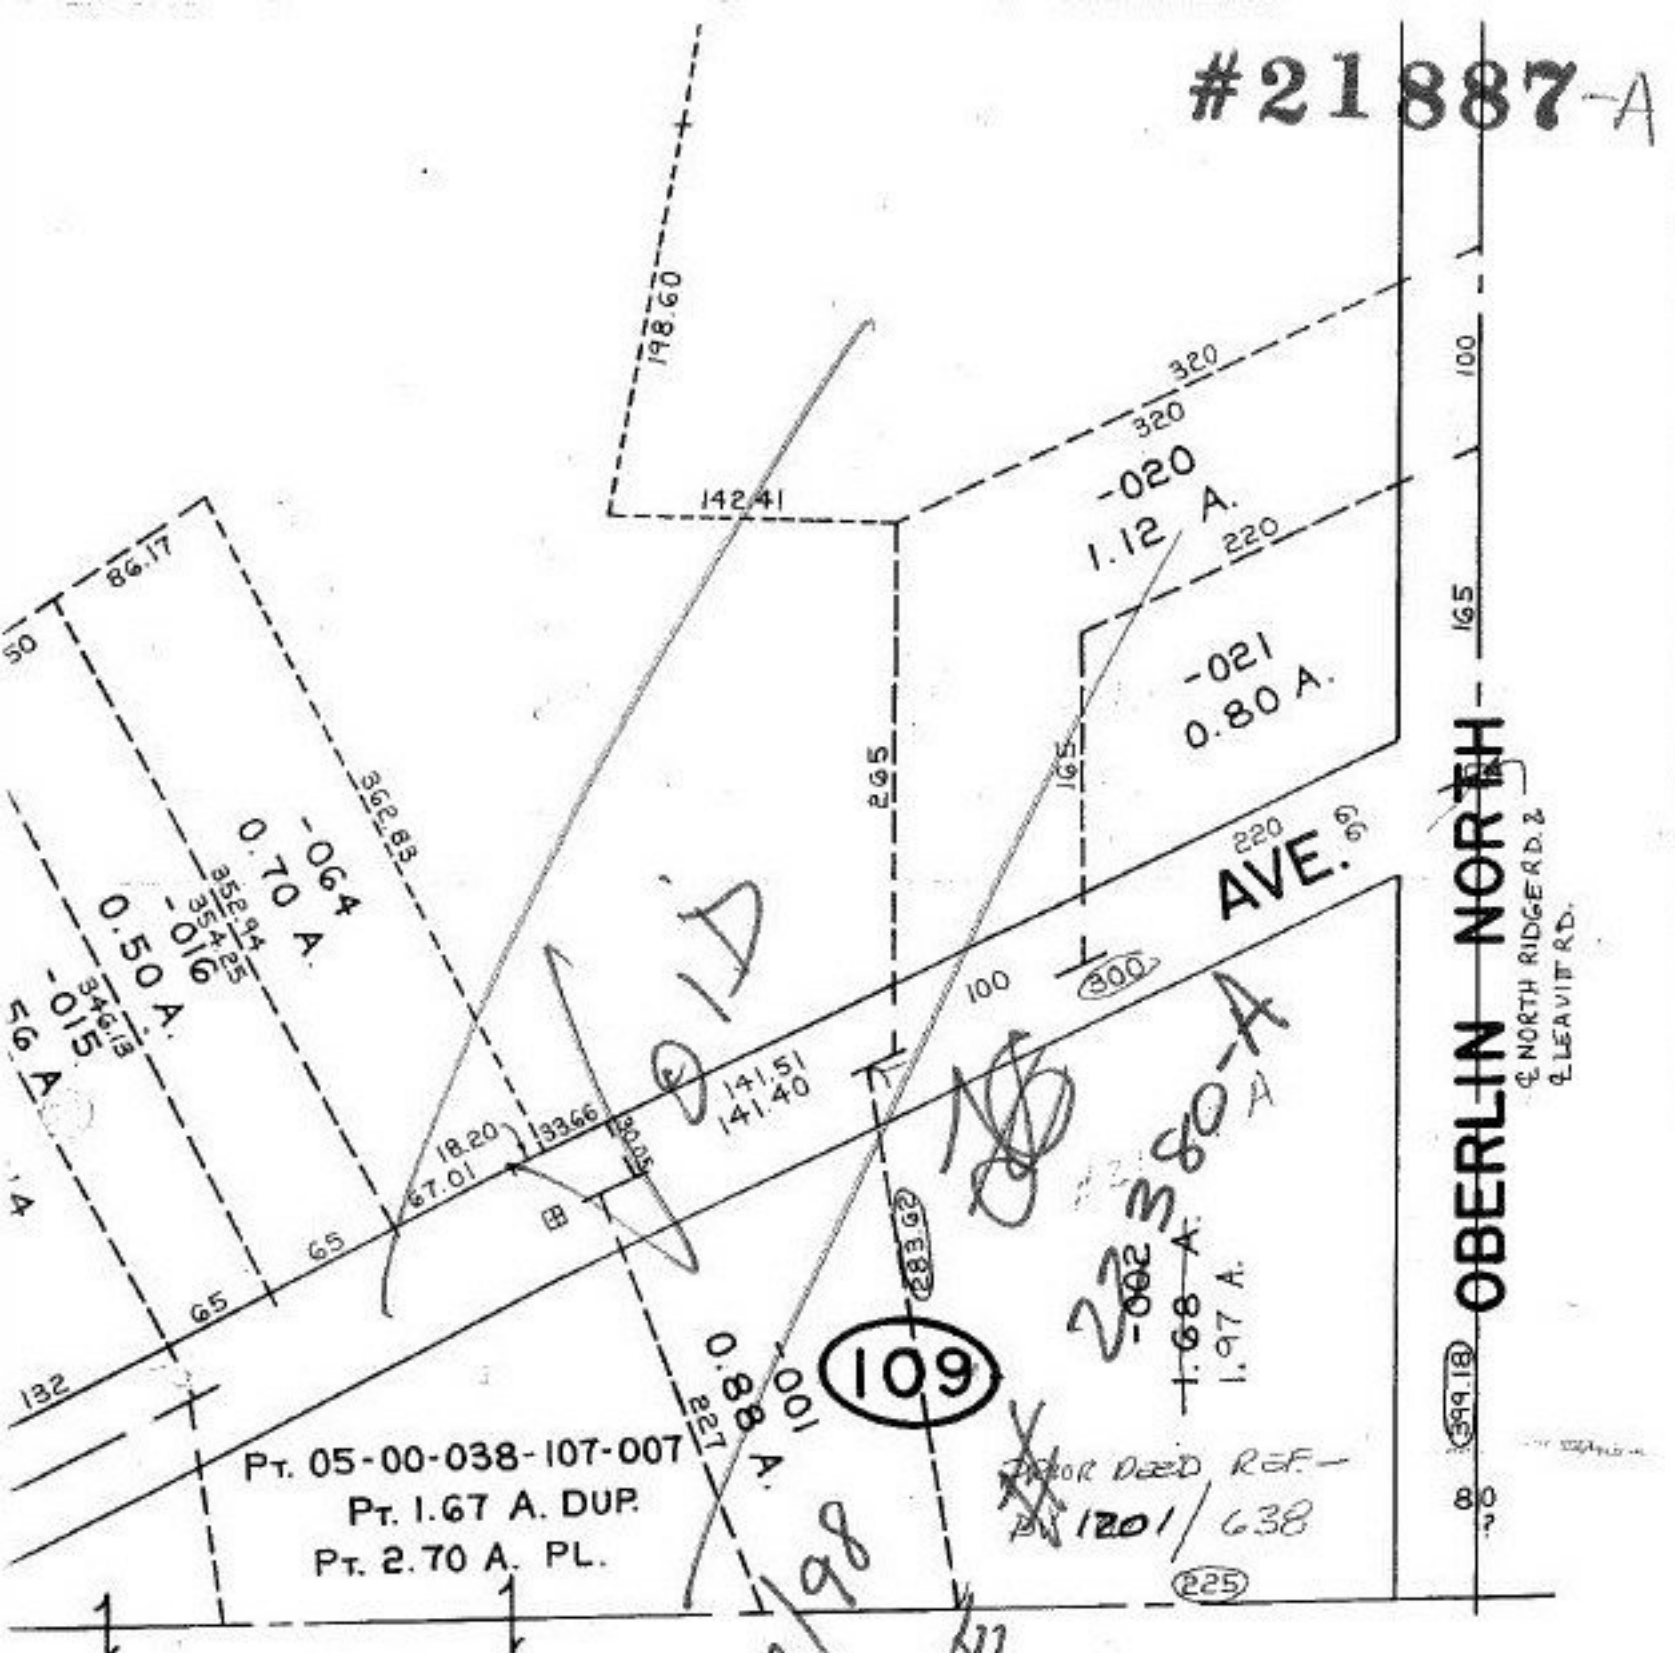

5-00-038-B

OBERLIN NORTH
NORTH RIDGE RD. 2
CLEAVIT RD.

109

1/23/98

SEE

2002-380-A

PT. 05-00-038-107-007
PT. 1.67 A. DUP.
PT. 2.70 A. PL.

21887-A

APPROVED
LORAIN CO.
MAP DEPT.

DATE 8-19-96

PAGE 5-00-039-B

BY KJYE

VOID AFTER 21887-A

AGREEMENT
CORRECTION