

#21898

21898
APPROVED 48 60 A
LORAIN CO.
MAP SEPT.
DATE 11-19-76
PAGE 1-1
BY R. BELL
VOID AFTER 21898

1097.88

230
-007
1.50 A
230

767.88
RD
60

79

-OTT
96-55 A

-015
54.17 A

64.42 A

PT. 3.12 A

COUR PER-
NATURE A
SURVEY

PT. 018
PT. 3.95 A

PT. 3.12 A


PT. 3.12 A

1.60 A
-012

5.60 A
-029

533.88
PORTMAN
60

531.54
-004-1.00 A
-005 1.00 A

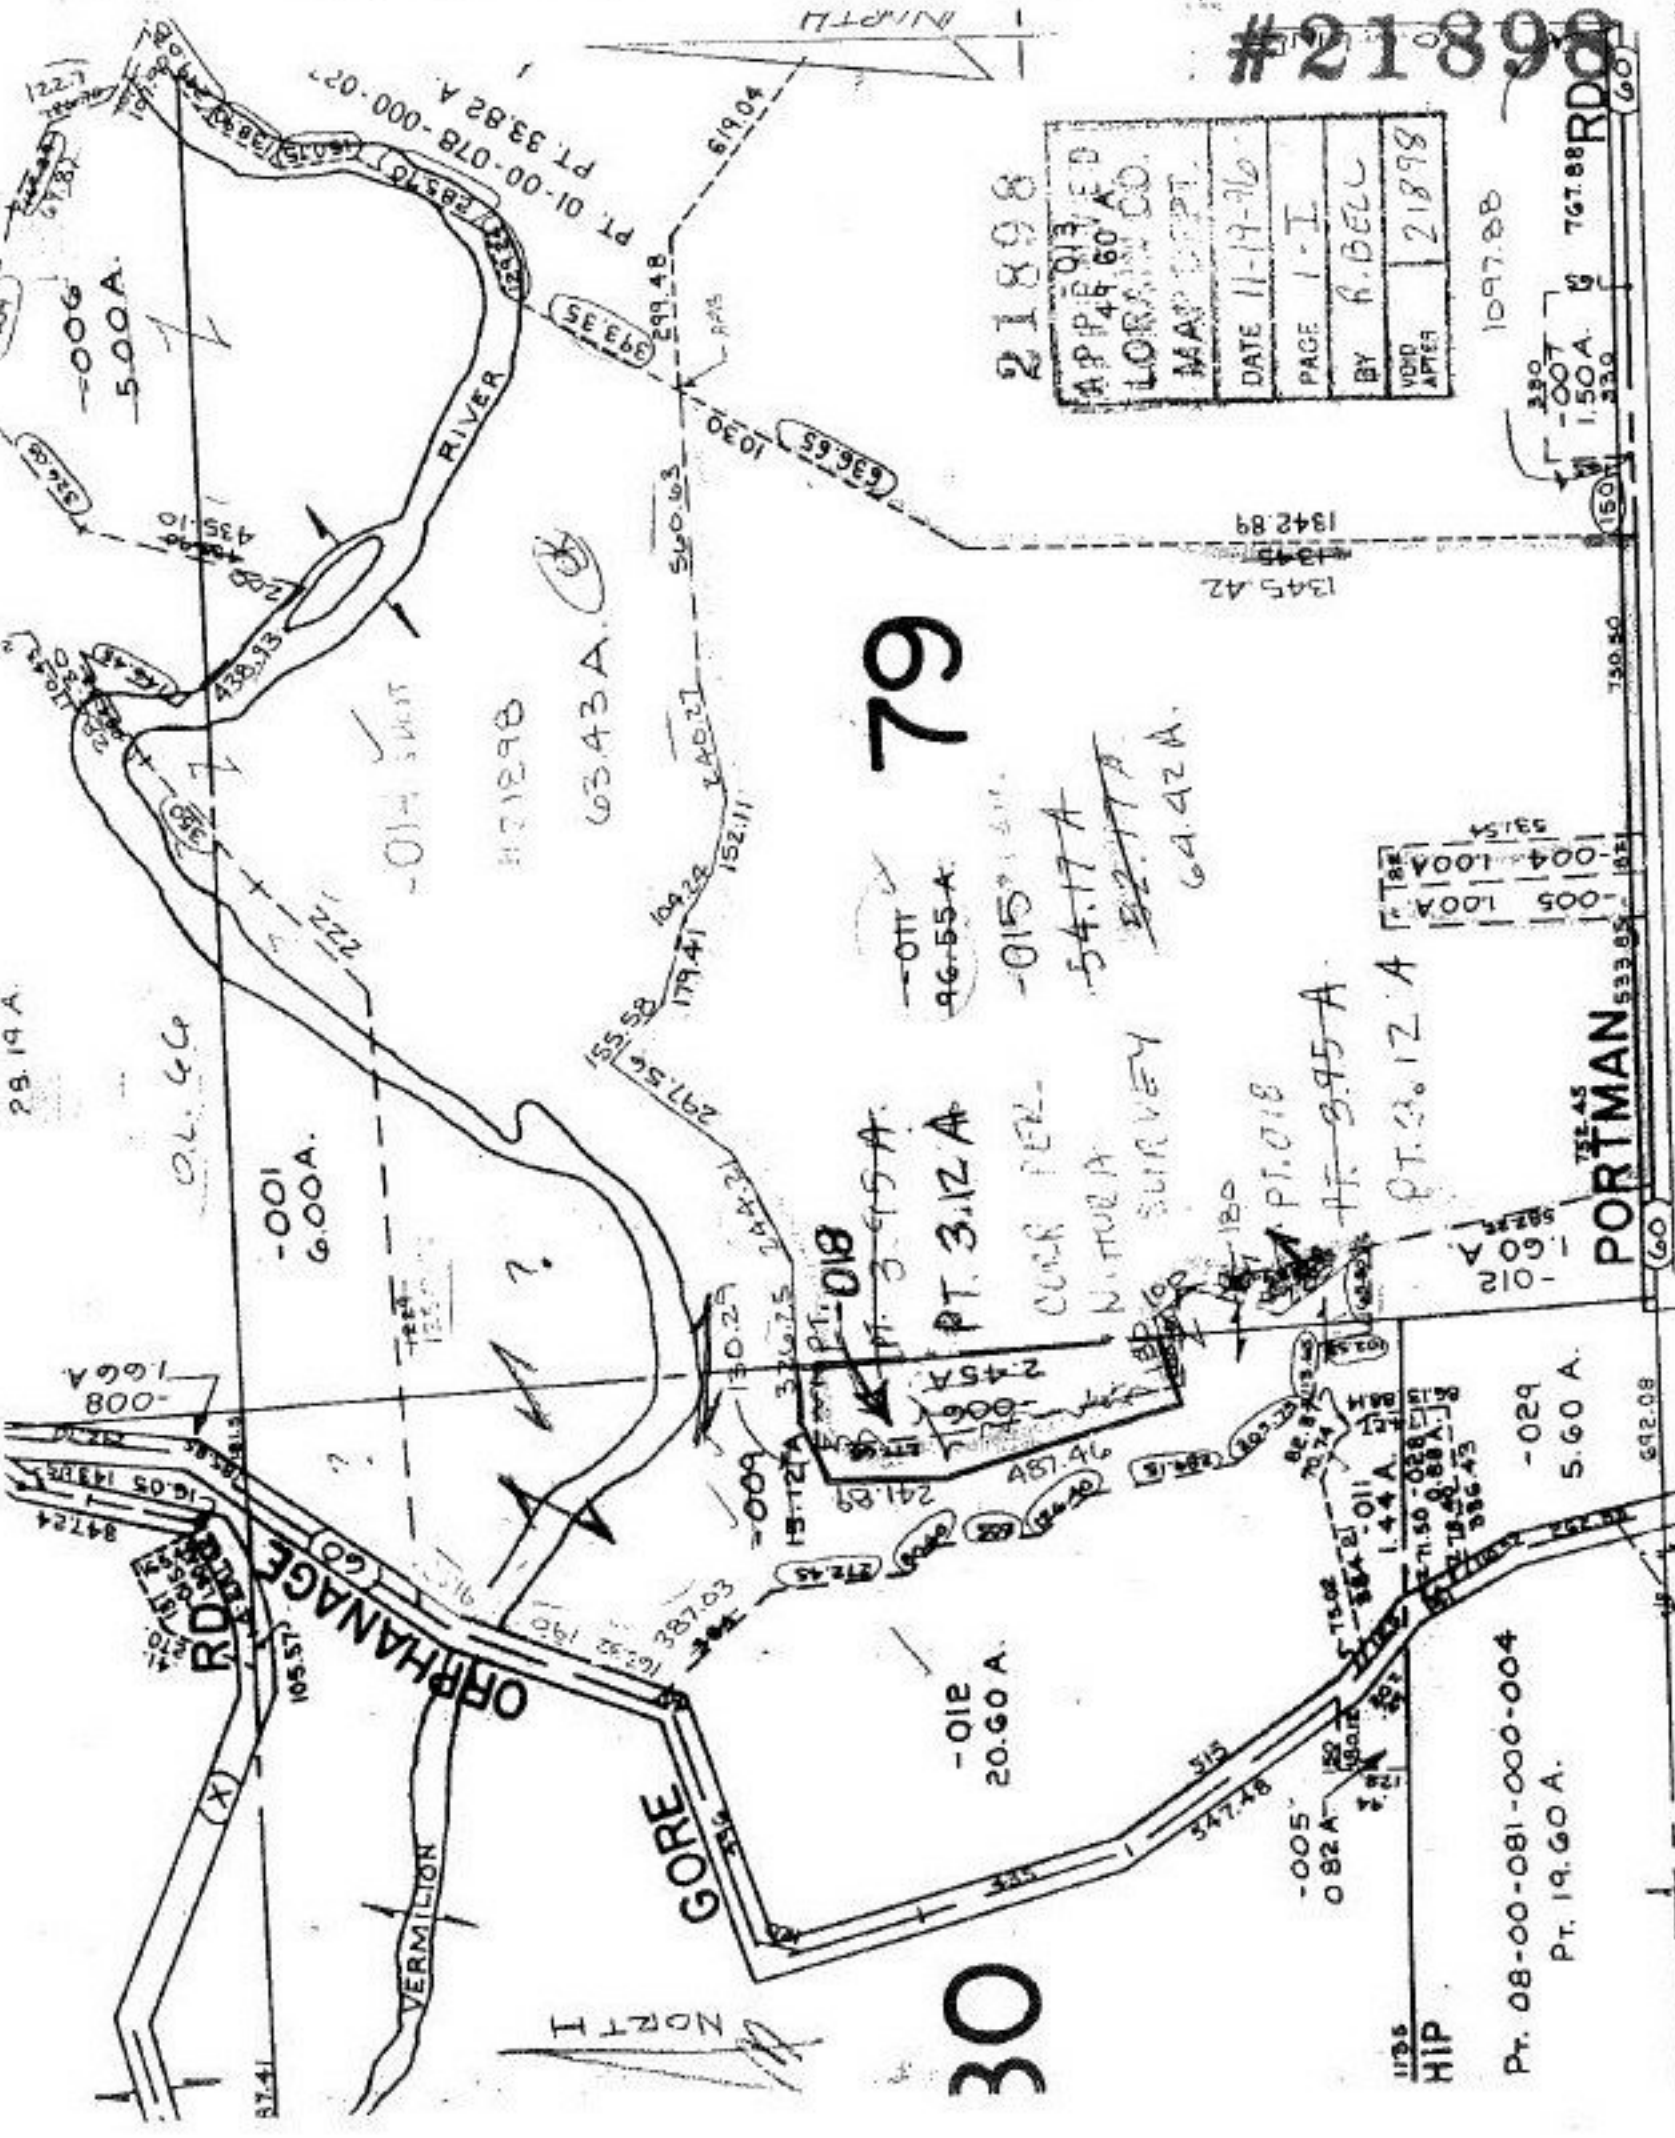

30

1136
HIP

PT. 08-00-081-000-004
PT. 19.60 A.

-012
20.60 A.

-001
6.00 A.

29.19 A.

-006
5.00 A.

PT. 01-00-078-000-027
PT. 01-00-078-000-027
619.04
299.48
1030
636.65
1345.42
1942.89
150.50
150.50
150.50