


SI

#21904

begins:
 E.S. Abbe Rd. 1. Extension of
 N. Line of Sublot 18 in Oakdale
 Est. #1 (54/36+37) Then
 N-2-00-00-E 537.09 To s. line of O.L.1

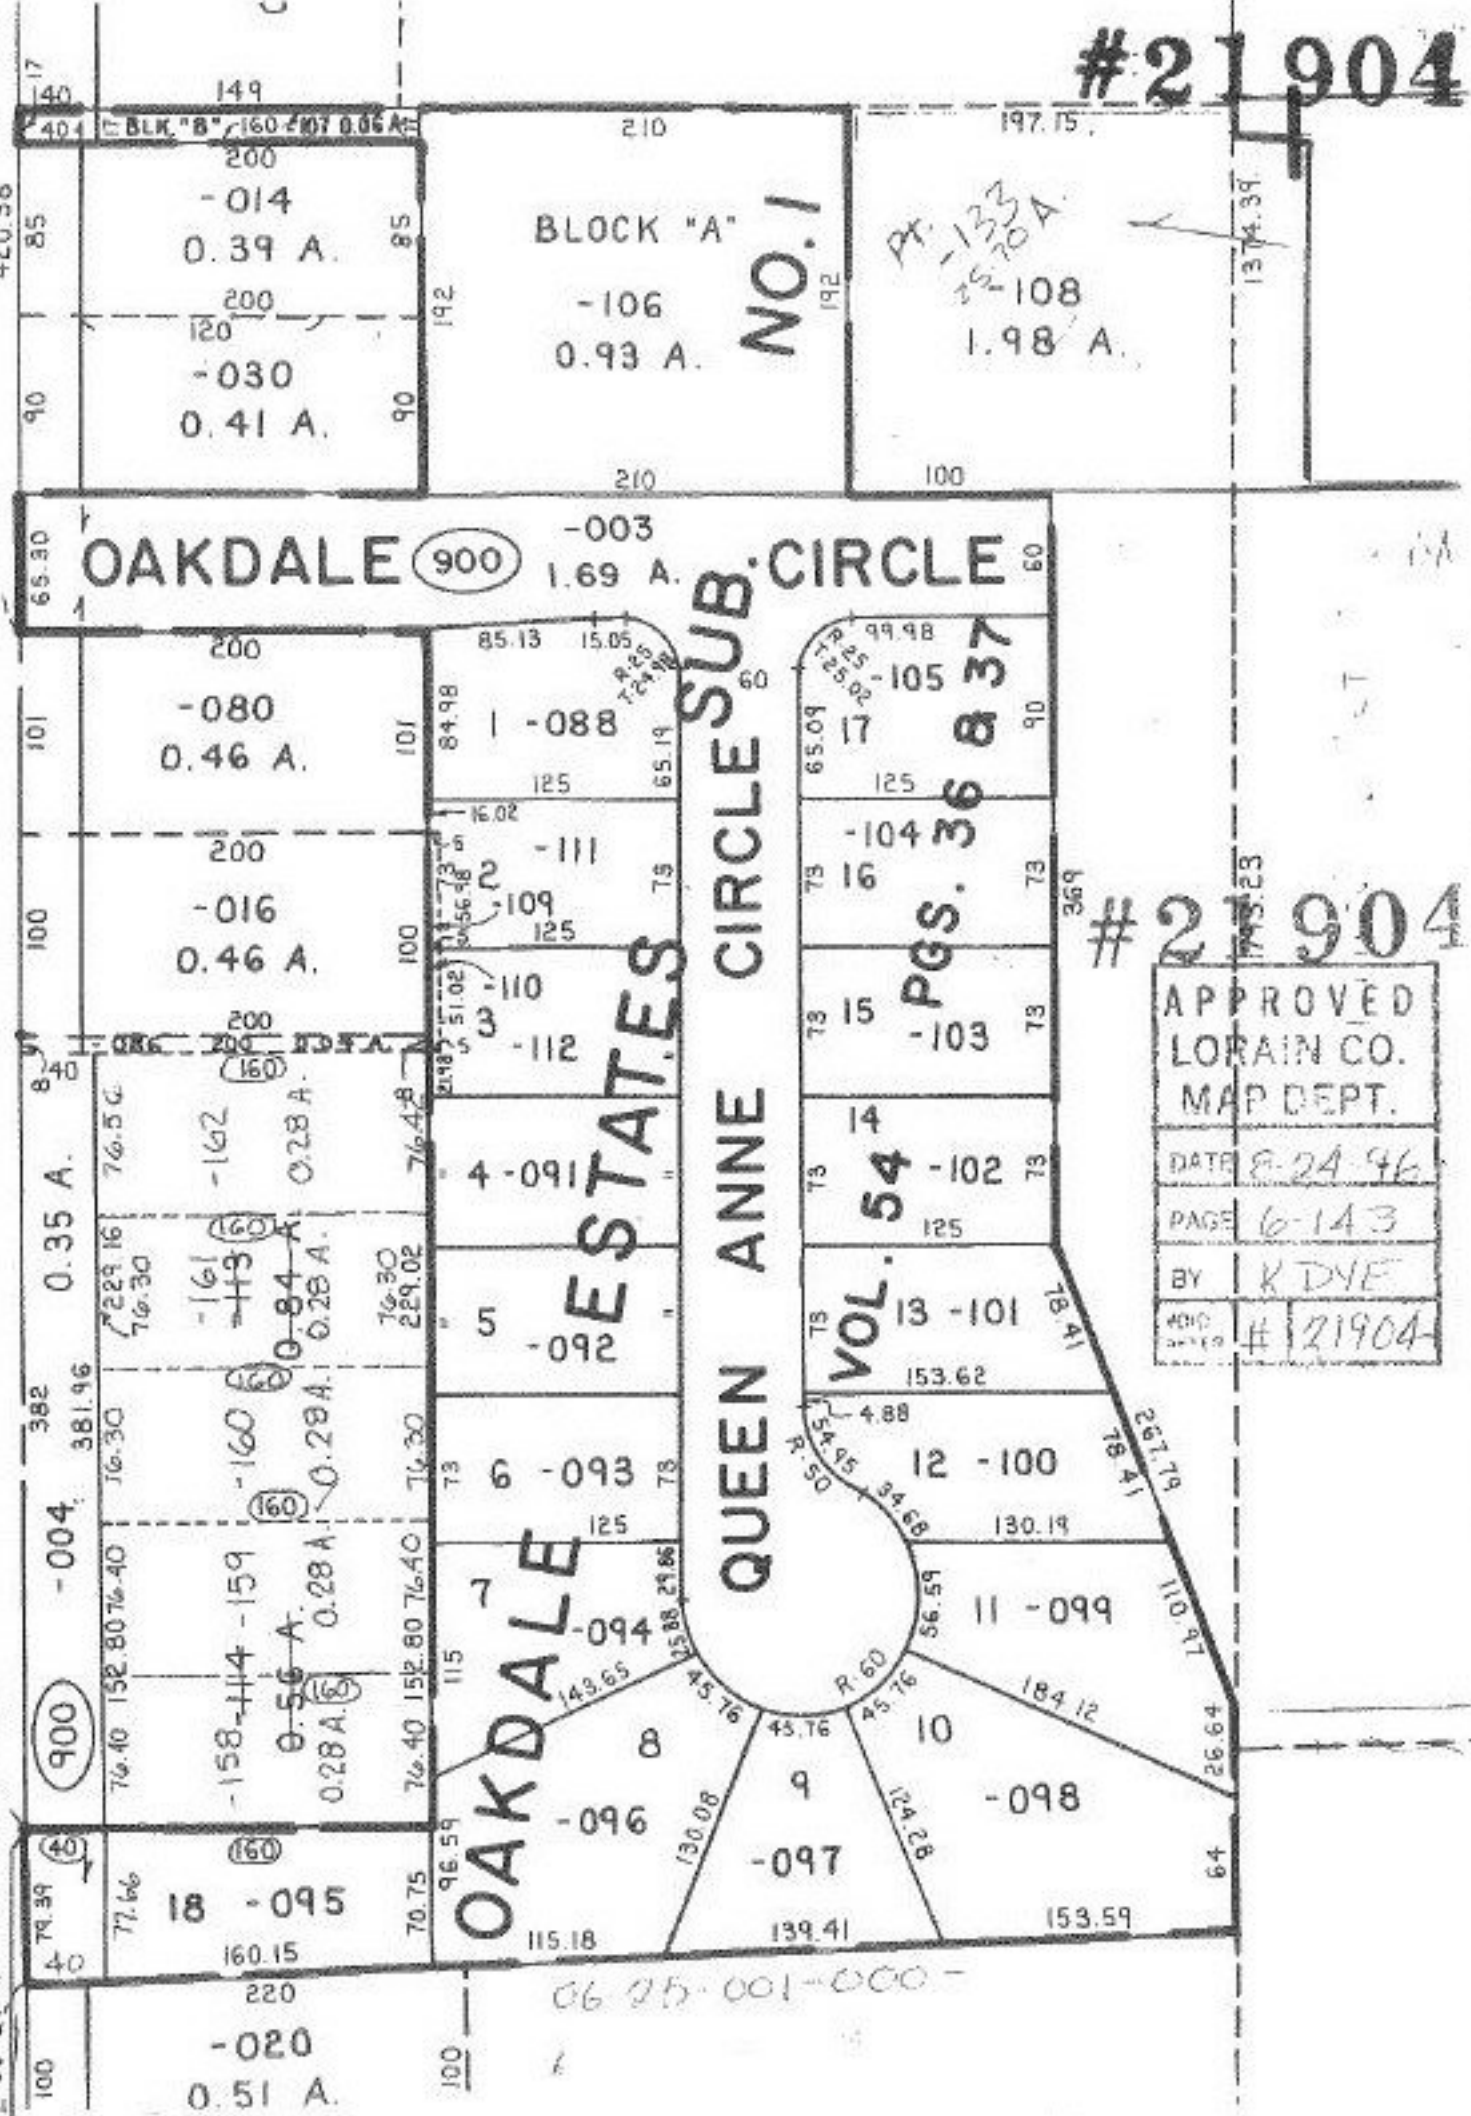

#21904

APPROVED
 LORAIN CO.
 MAP DEPT.

DATE 8-24-96

PAGE 6-143

BY K DYE

#21904

06 25 001-000-