


# #21906

SEE 4-00-01

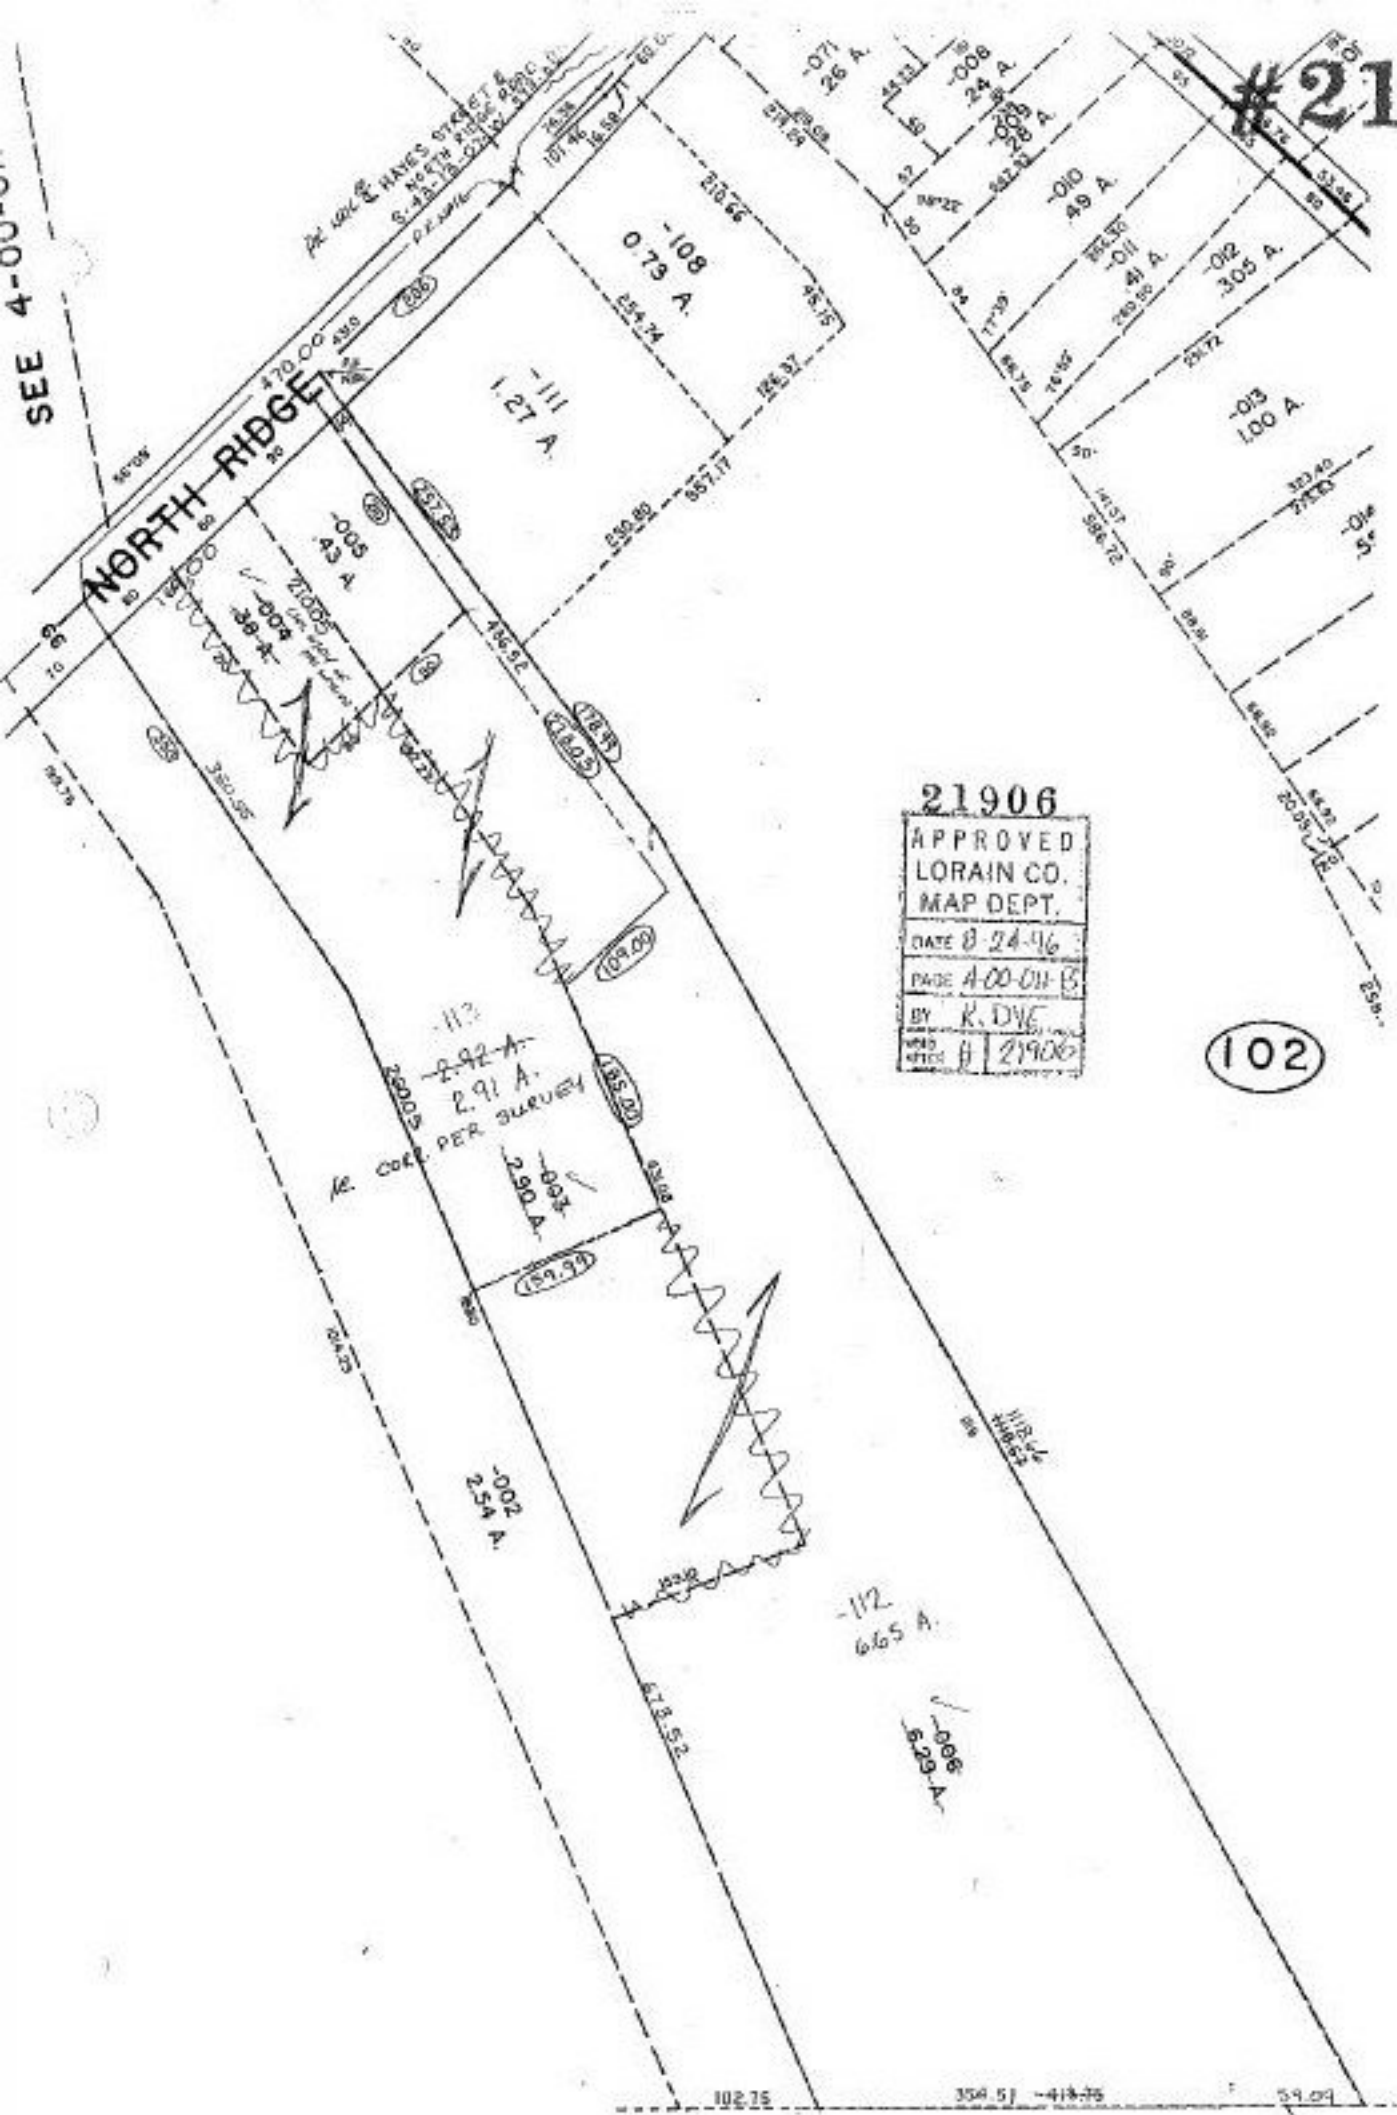

21906  
 APPROVED  
 LORAIN CO.  
 MAP DEPT.  
 DATE 8-24-46  
 PAGE 4-00-01-B  
 BY R. DYE  
 MAP  
 OFFICE # 21906

102

SEE 4.