


SEE 7-A

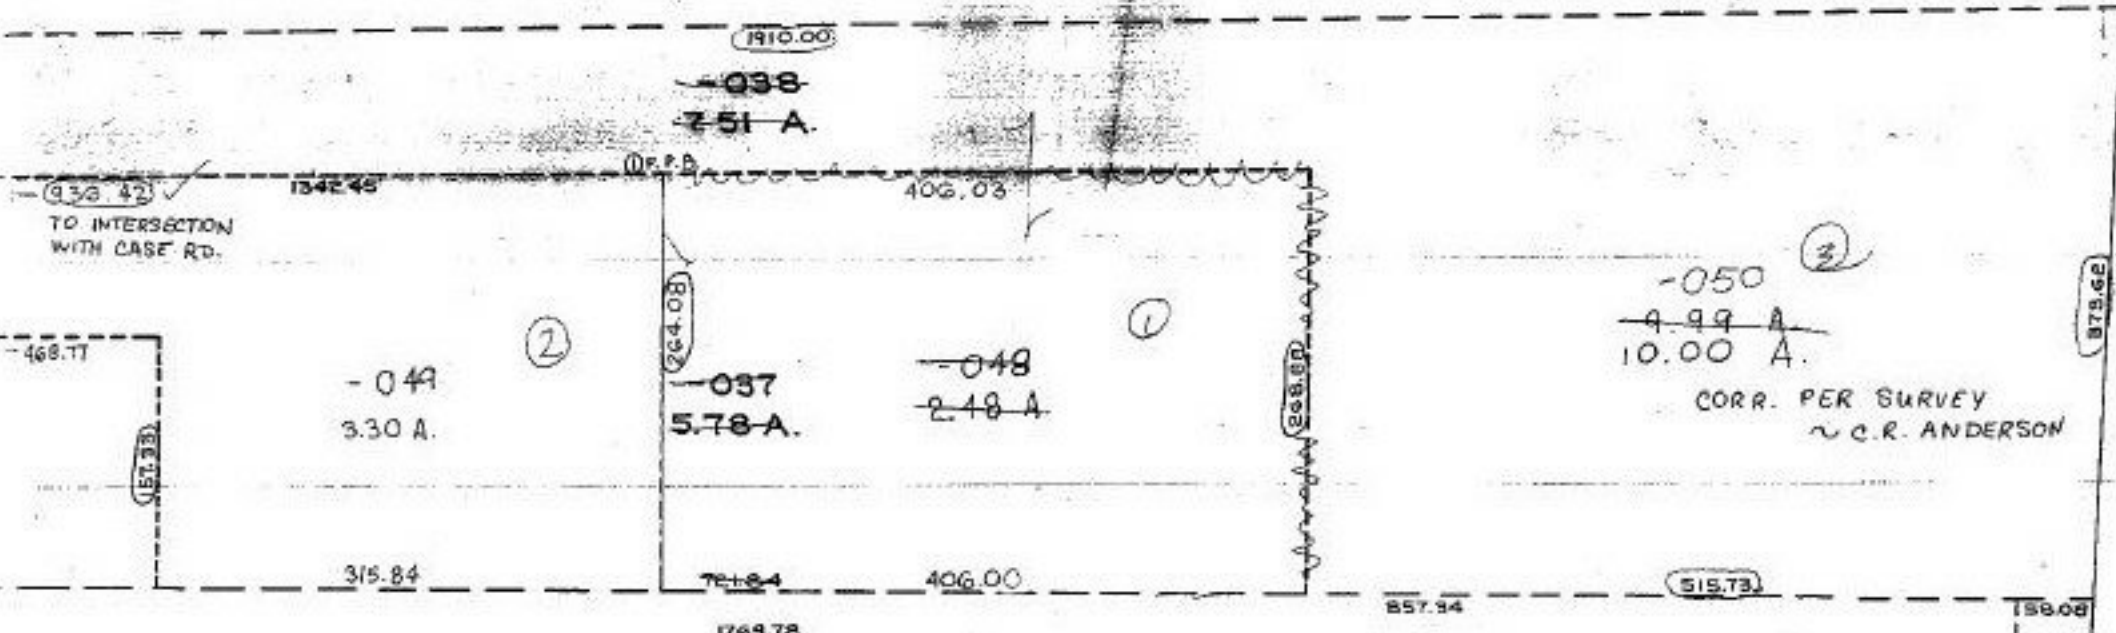

103

-034
13.97 A.

21912

APPROVED
LORAIN CO.
MAP DEPT.
DATE 9-10-96
PAGE 7-00-044-D
BY K.DYE
VOID AFTER 21912

#21912

137