


#21916

RD.

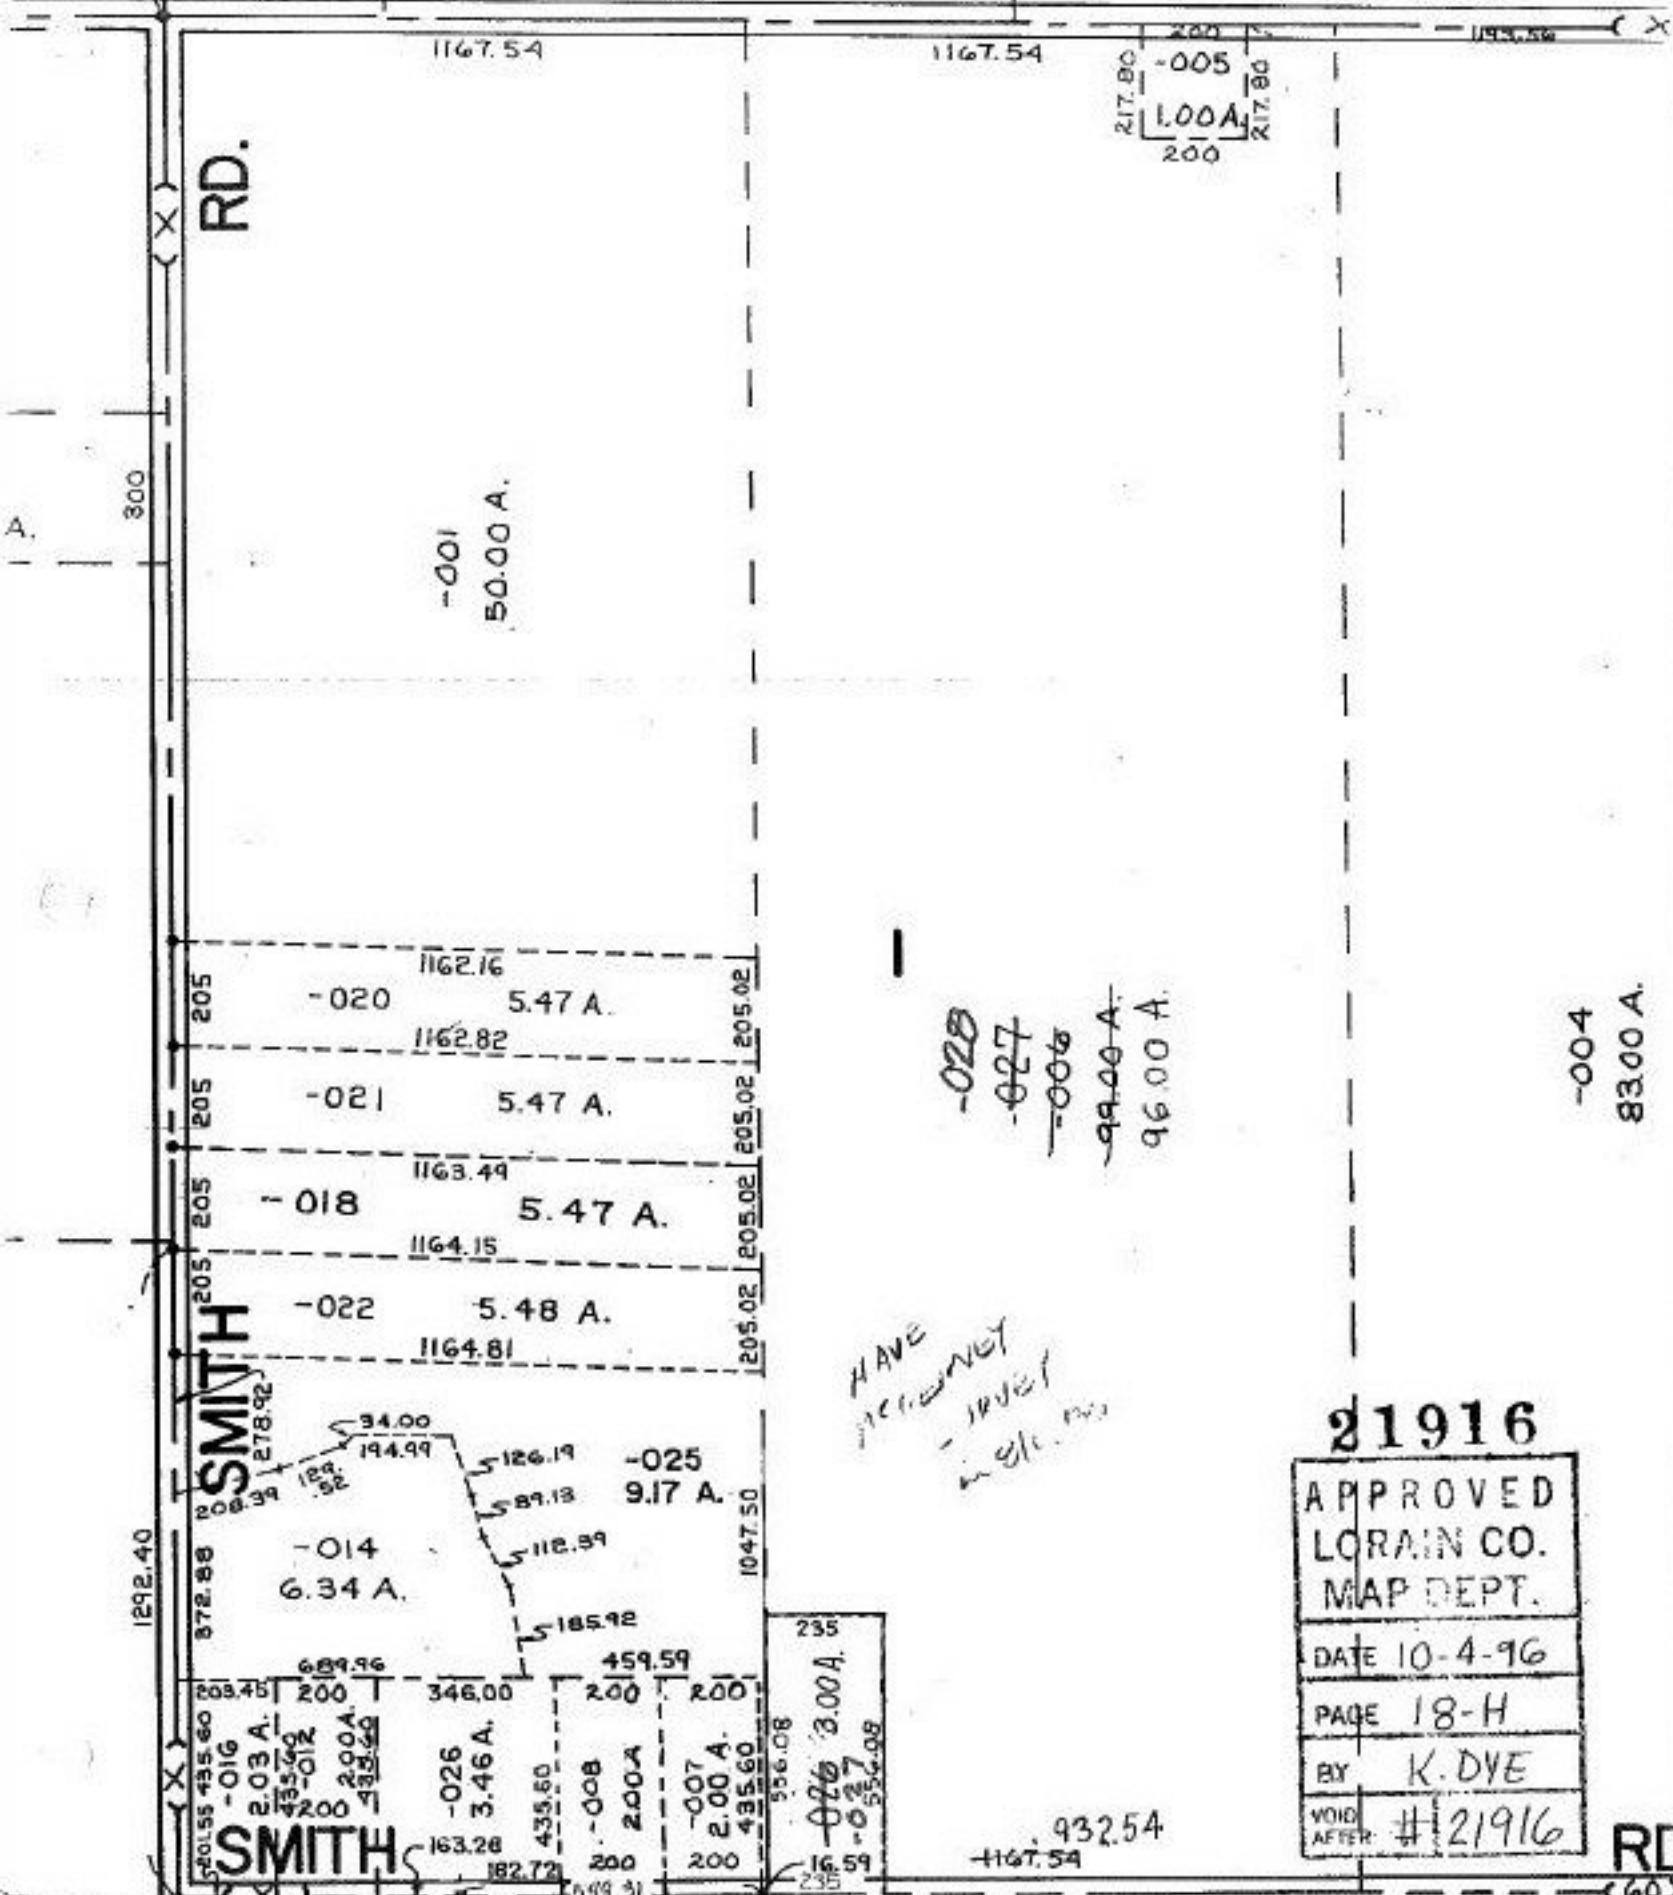

-028
 -027
 -006
 -99.00 A.
 96.00 A.

-004
 83.00 A.

HAVE
 AGENCY
 - INVEST
 in site.

21916
 APPROVED
 LORAIN CO.
 MAP DEPT.
 DATE 10-4-96
 PAGE 18-H
 BY K. DYE
 VOID AFTER #21916

RC
 (60)