




DETAIL

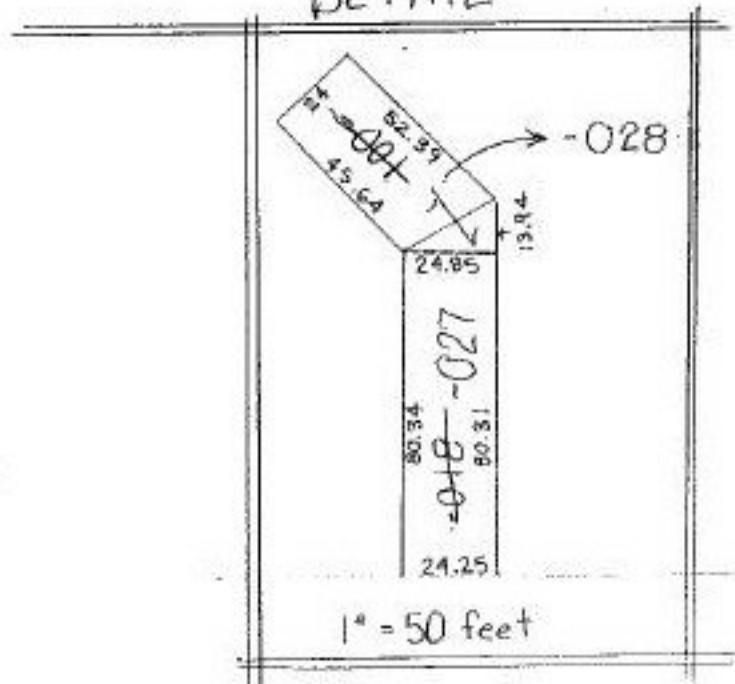

21925
 APPROVED
 LORAIN CO.
 MAP DEPT.
 DATE 10-1-96
 PAGE 18-00-028-D
 BY K.DYE
 VOID AFTER #21925