

#21928


WEBBER

DEED MATCHES
MAP - ACREAGE
IS CORRECT

NO CHANGES
OF TAX MAP

DEED
CHECK

MOORE

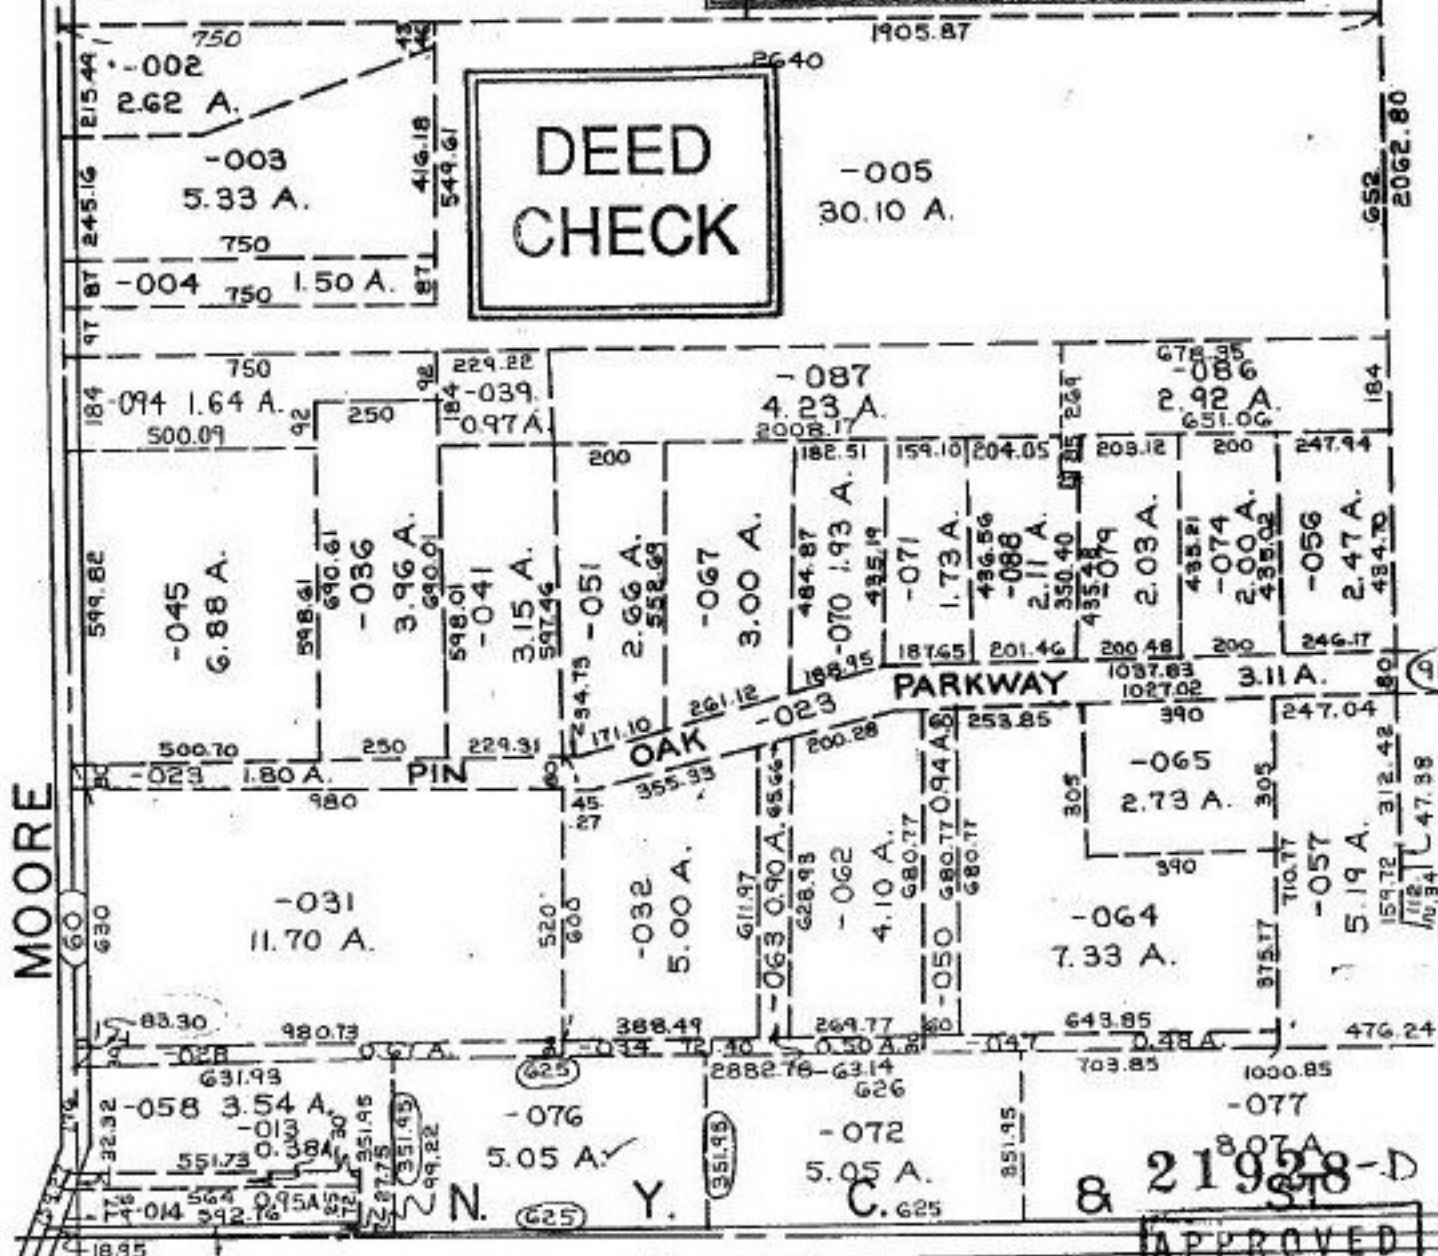

21928-D

APPROVED
LORAIN CO.
MAP DEPT.
DATE 10-14-96
PAGE A-B
BY K. DIE
VOID
AFTER # 21928