


21936-X

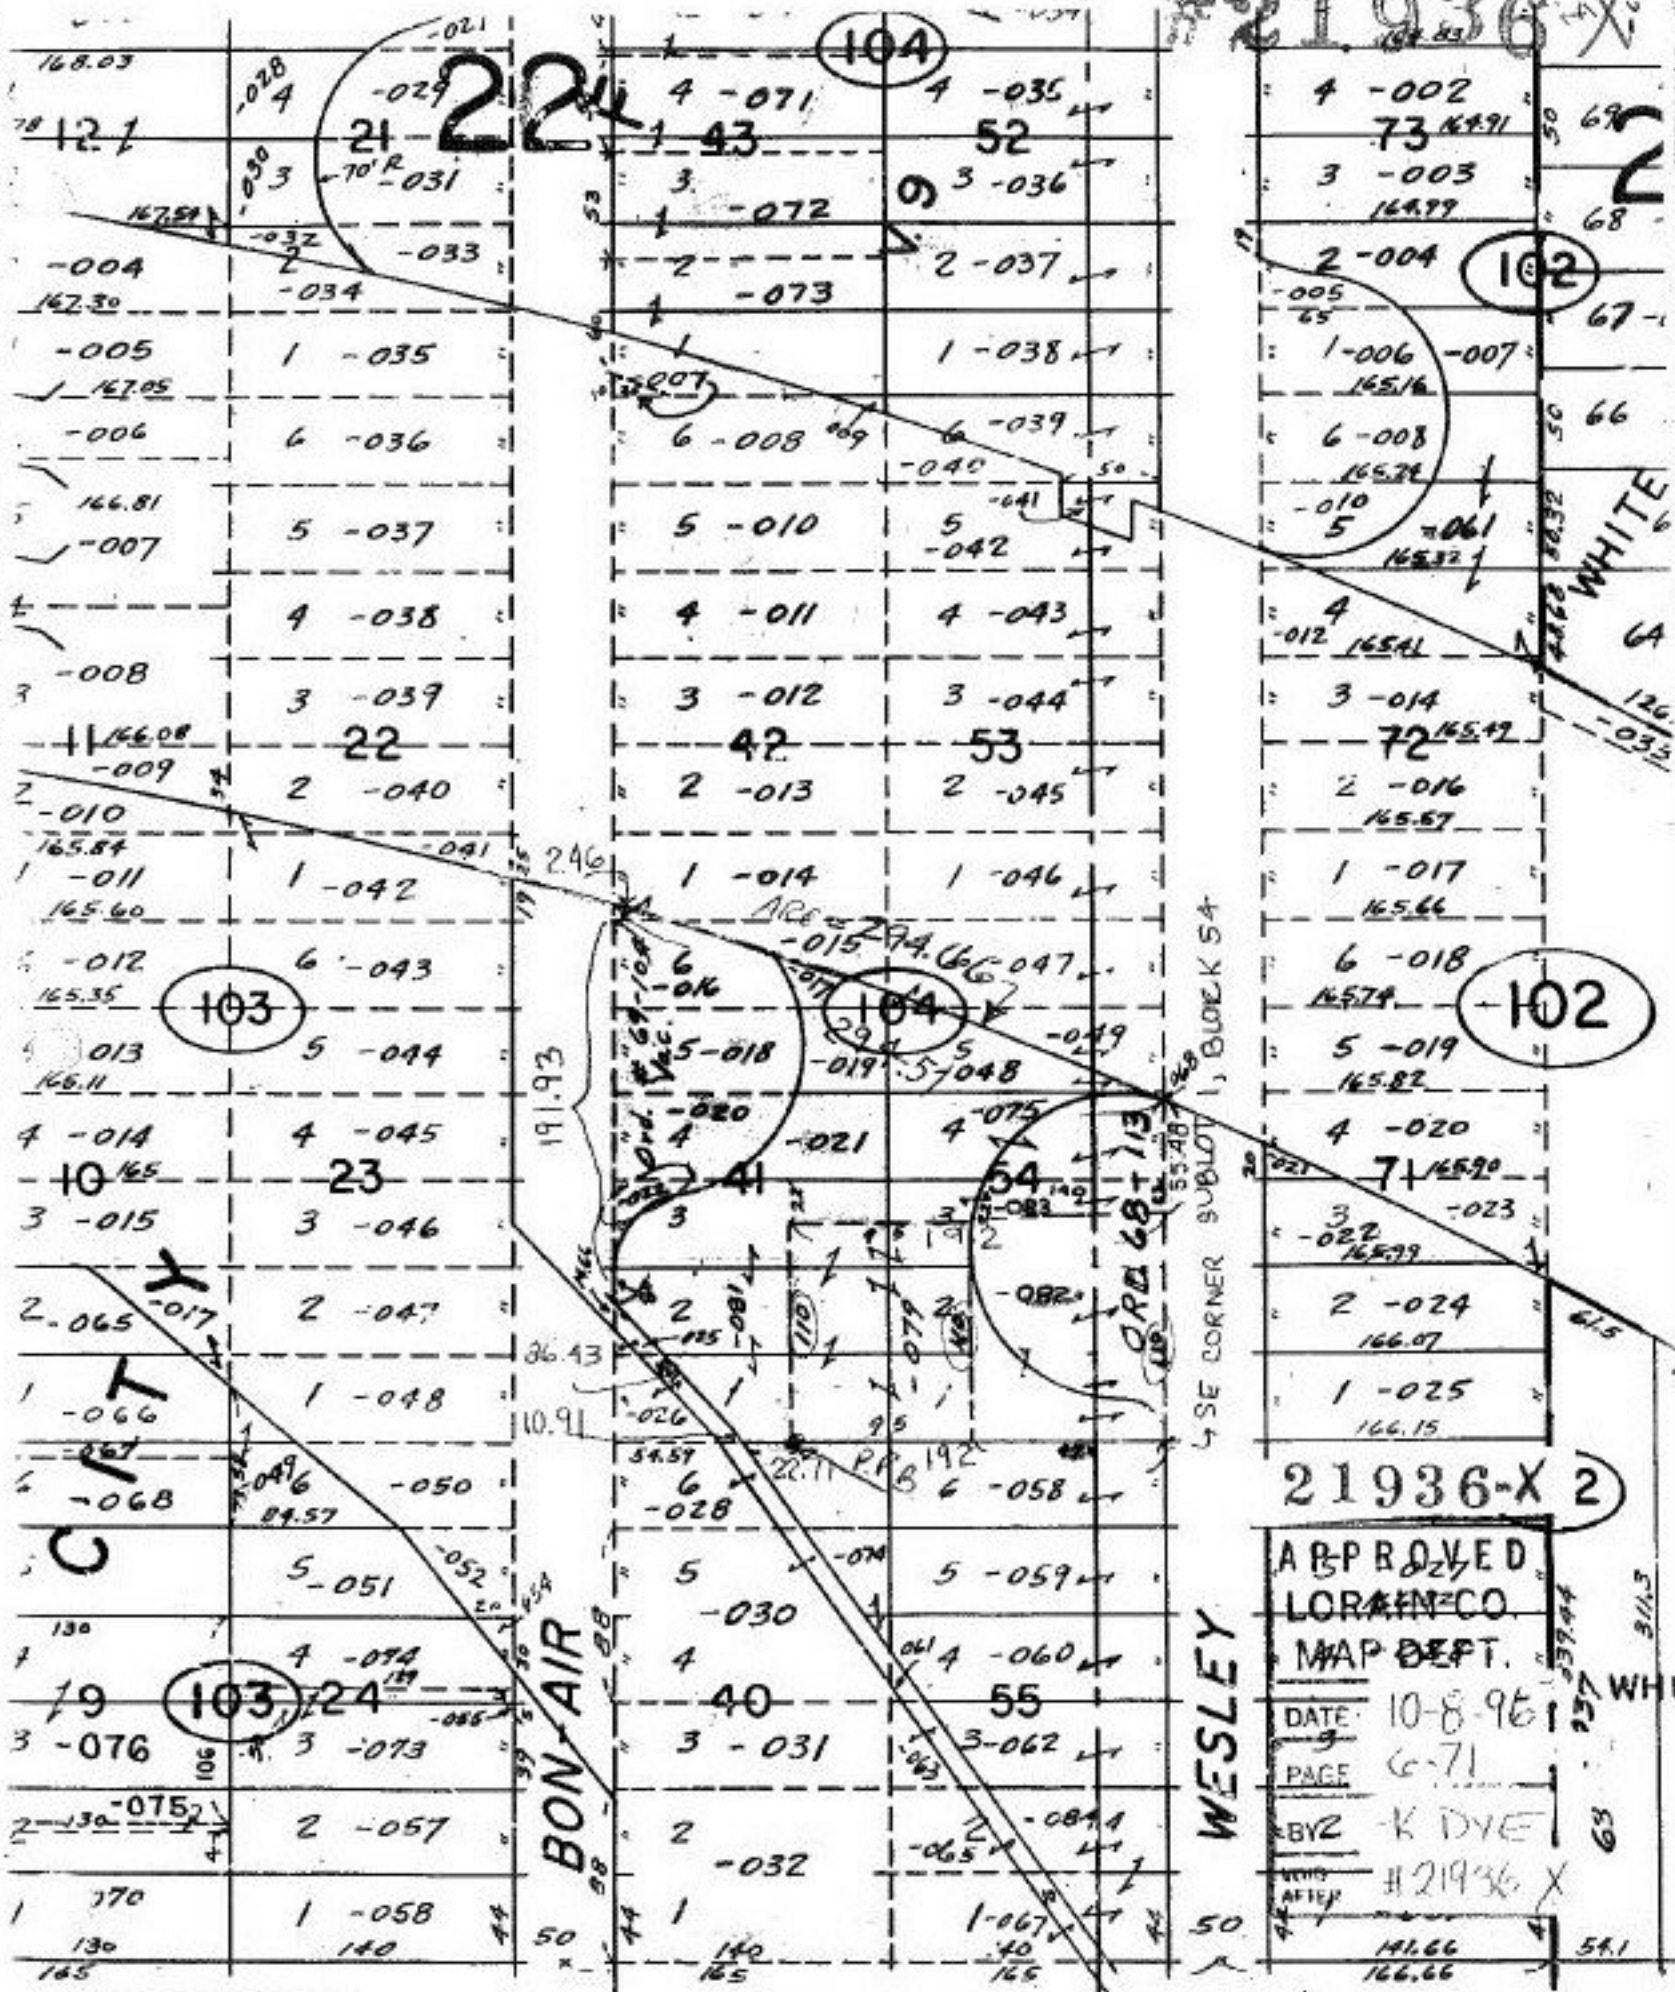

APPROVED
LORAIN CO.
MAP DEPT.

DATE 10-8-95

PAGE 6-71

BY K DYE

WESLEY

#21936 X

14.66 54.1

166.66

SYCAMORE

SEE 6-89