


#21938^A

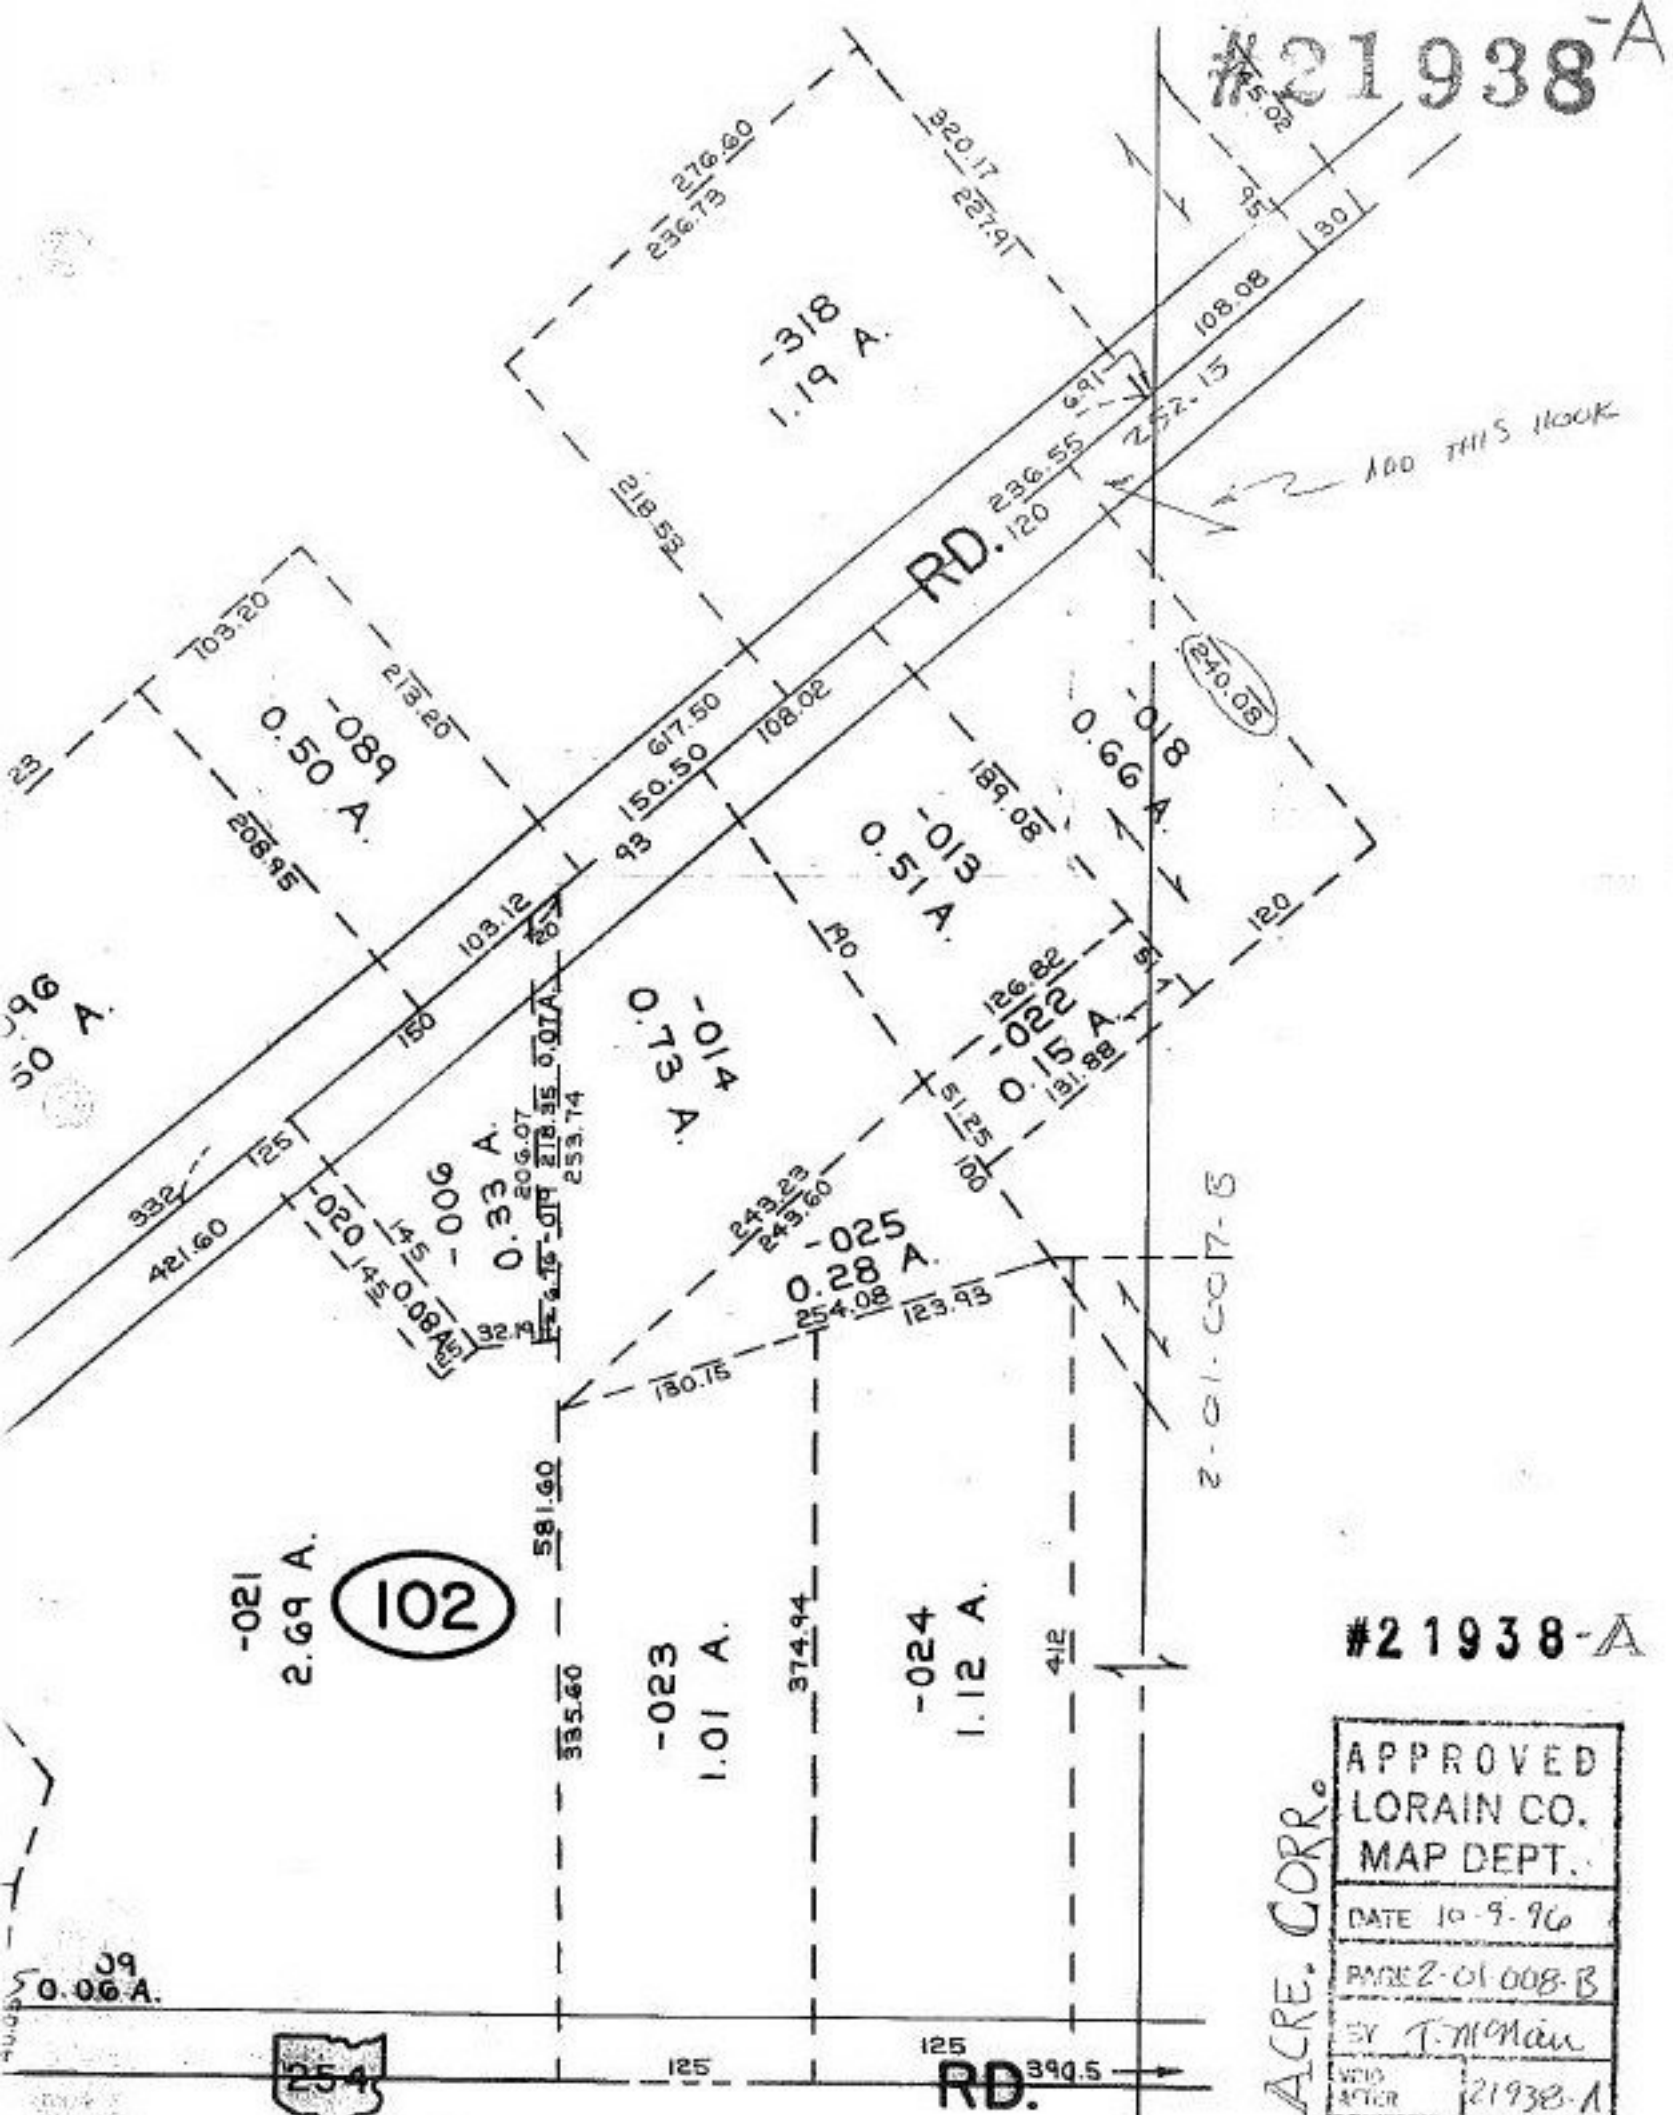

#21938-A

ACRE. CORR.

APPROVED
LORAIN CO.
MAP DEPT.
DATE 10-9-96
PAGE 2-01-008-B
BY T. McMan
WHD ACTOR 21938-A

61-B