


21940X

SUB # 21940
P. 25

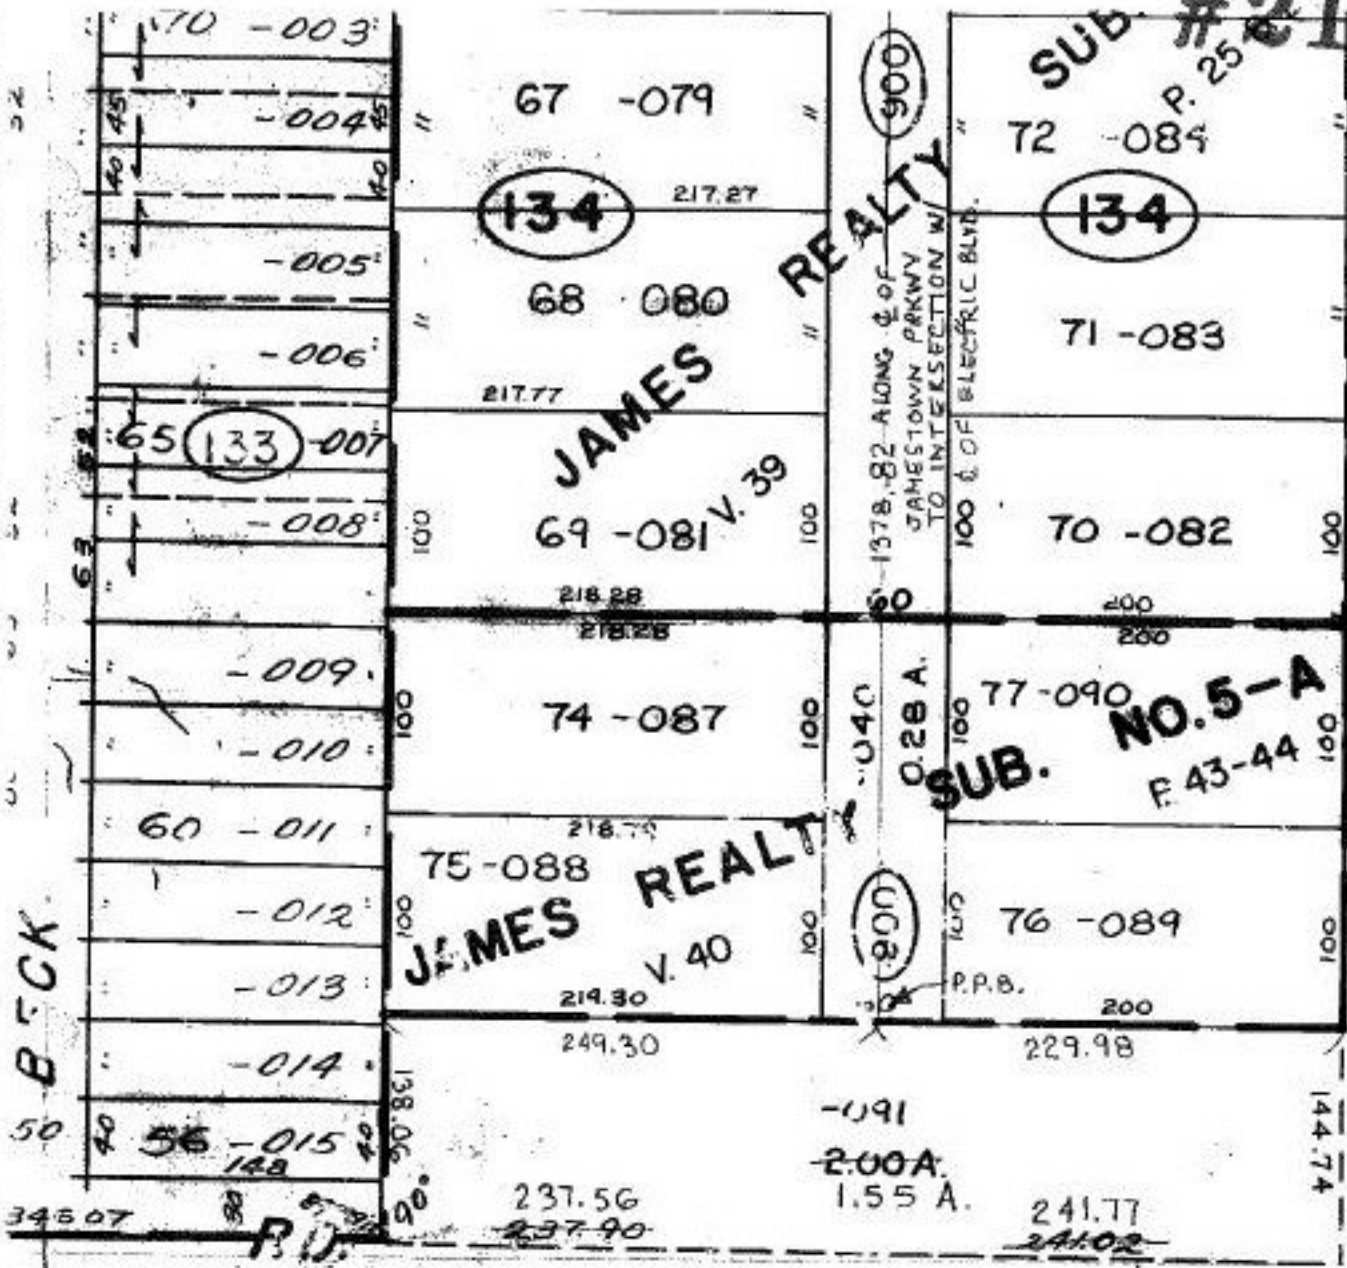

BECK

4-00-019-G

21940X

APPROVED
LORAIN CO.
MAP DEPT.

DATE 10-8-96

PAGE 4-00-019-C

BY K.D.YE

VOID AFTER # 21940-X