

#21947

21947


APPROVED
LORAIN CO.
MAP DEPT.
DATE 10-9-96
PAGE 6-46
BY K DYE
VOID AFTER #121947

pg. 6-146

N 1/4 30

GRACE
1/4 24

PT. 06-24

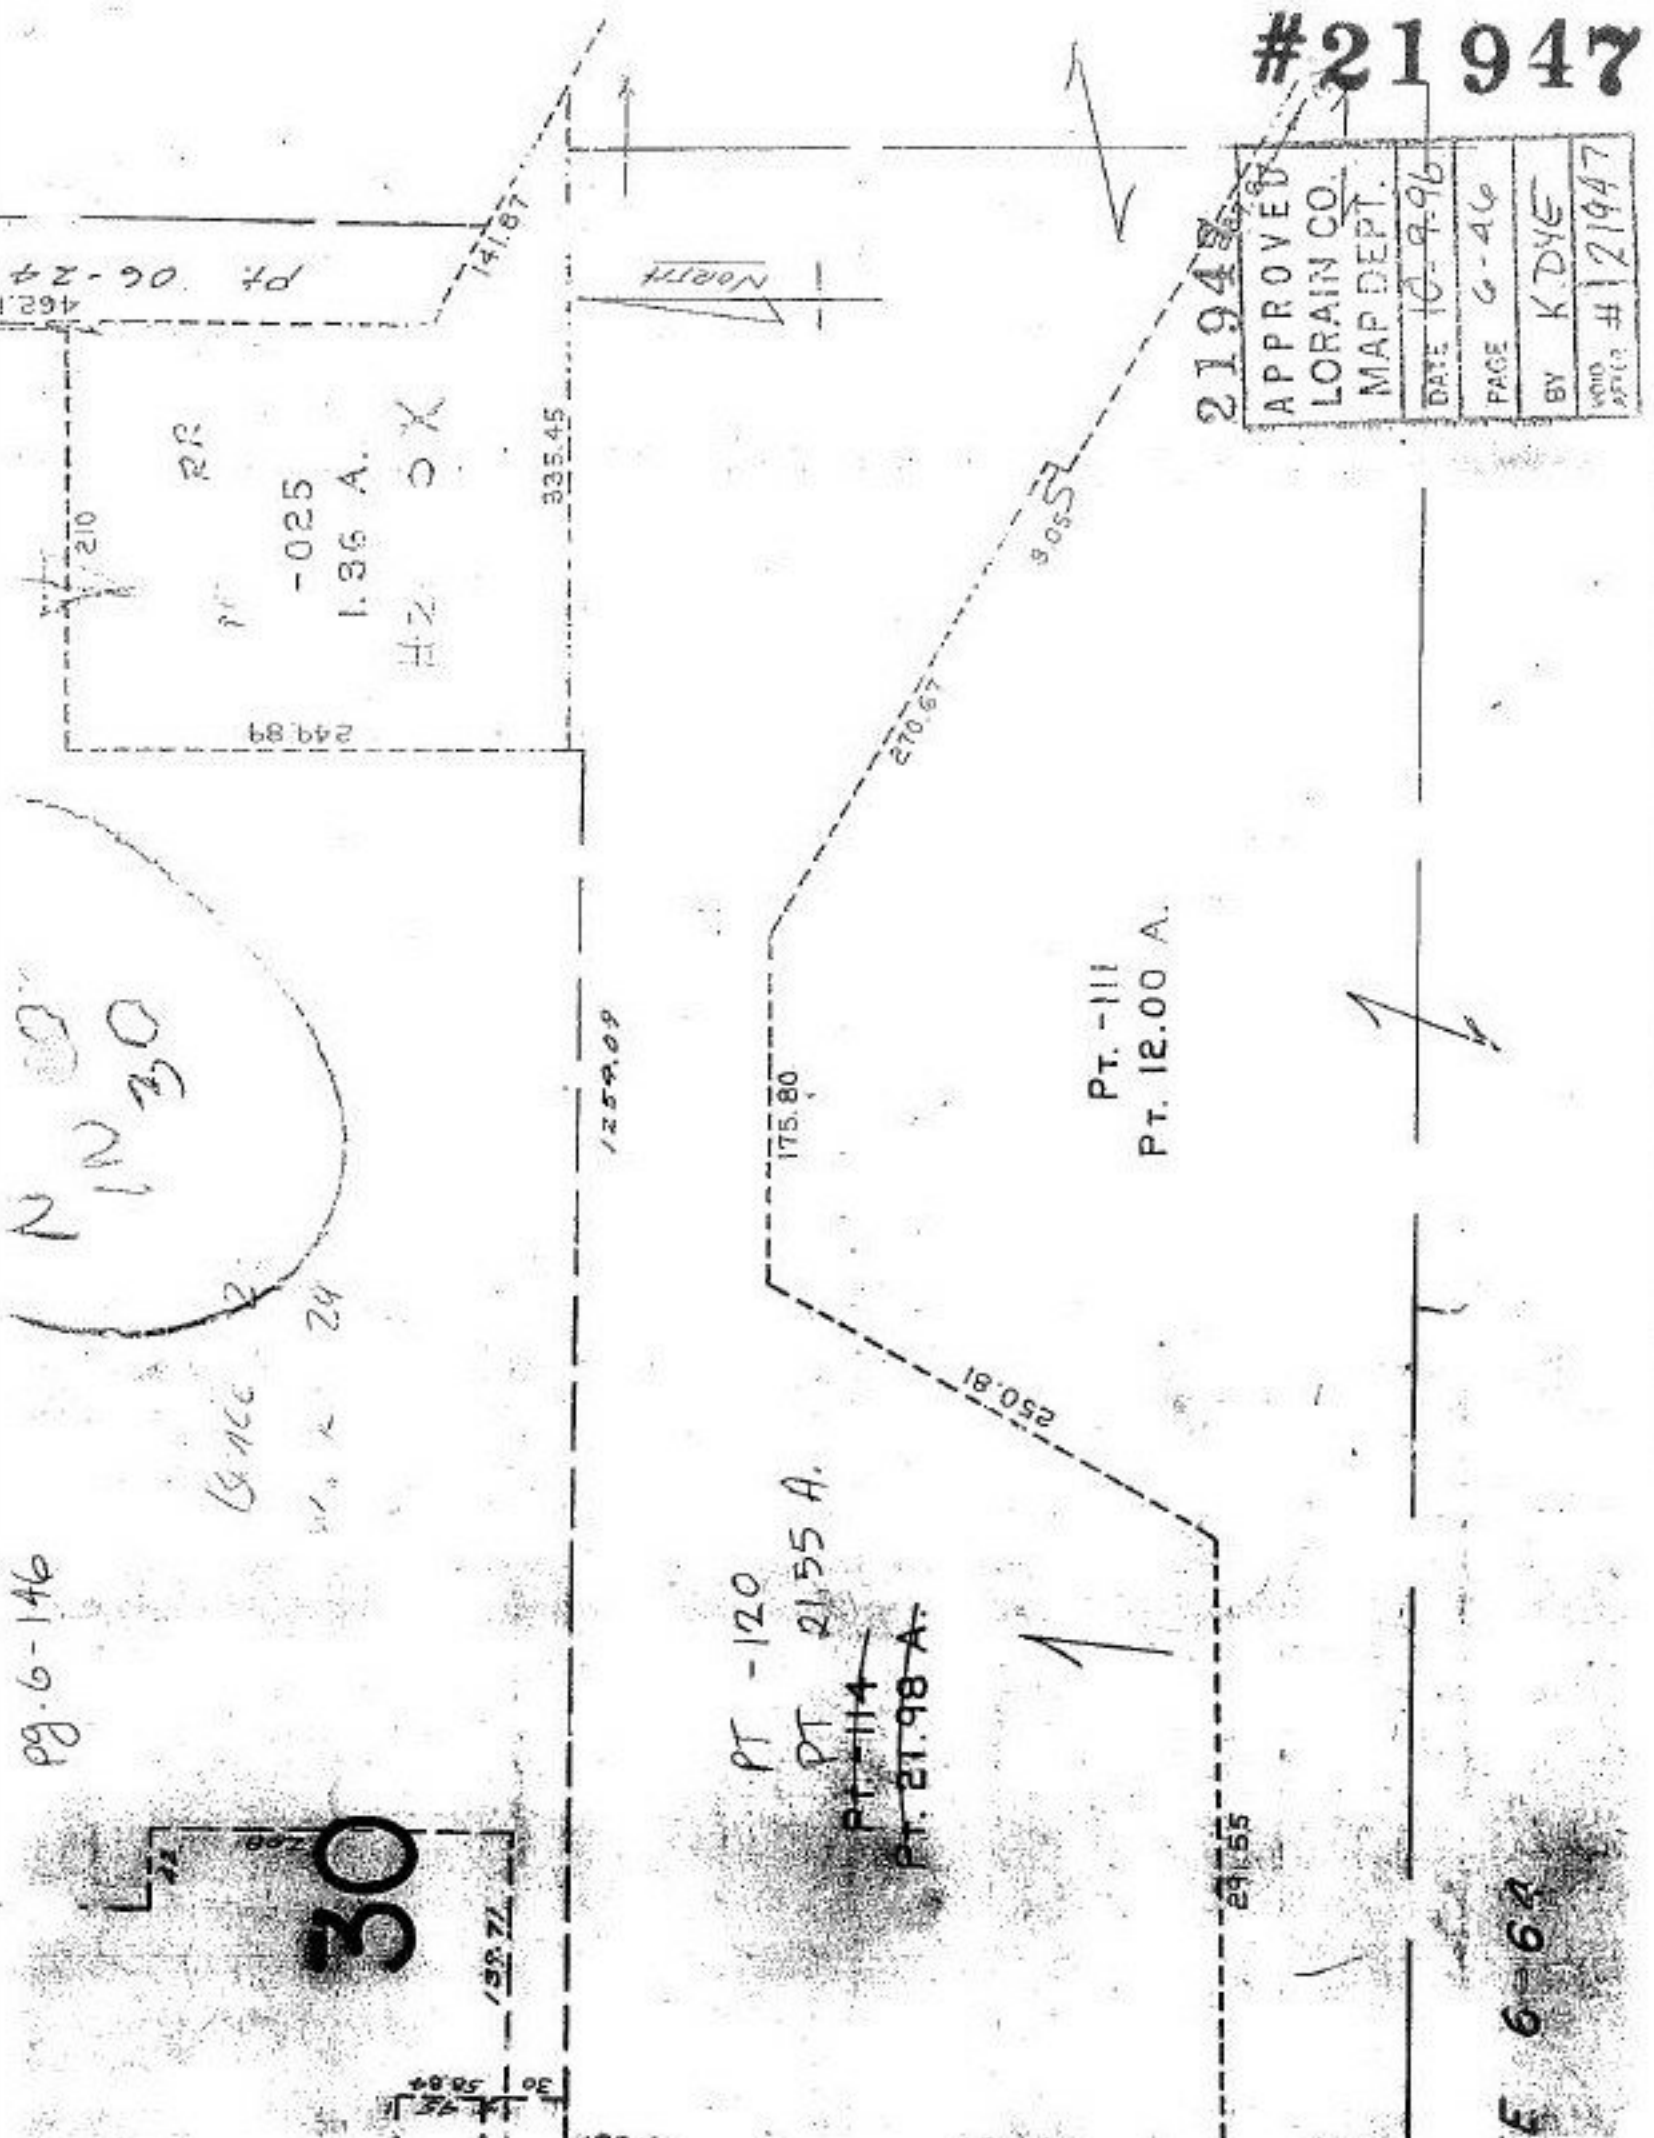

E 6-64