



~~-028~~
~~16.31 A.~~
21948

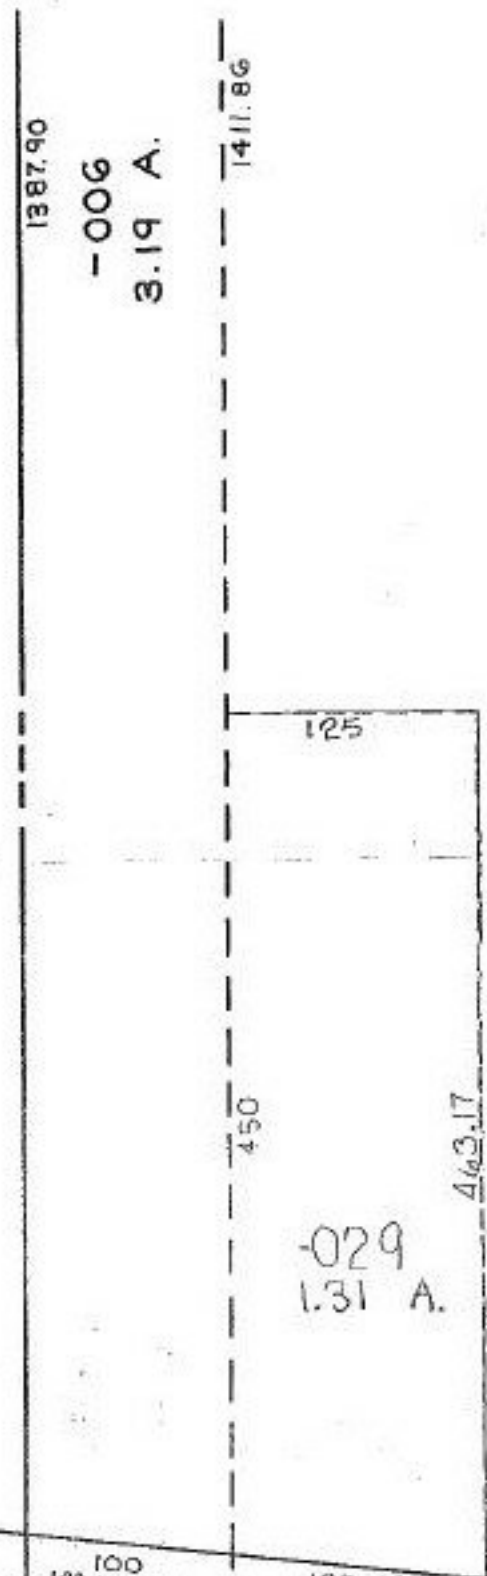

-030
15.06 A.

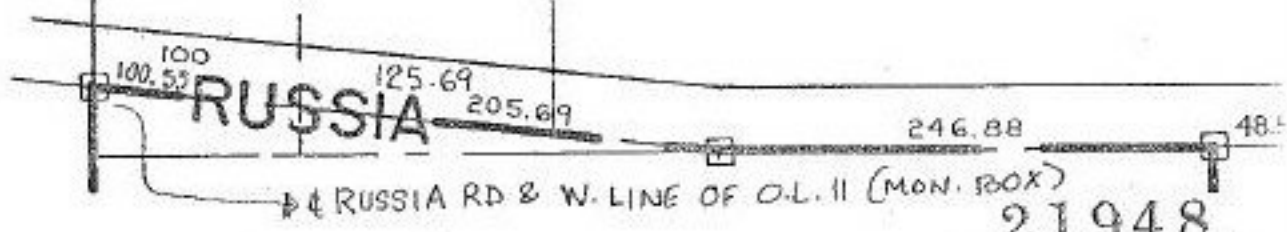

21948

APPROVED
LORAIN CO.
MAP DEPT.
DATE 10-9-96
PAGE 9-00-011-A
BY K. DYE
VOID AFTER # 21948