


#21950-X

24

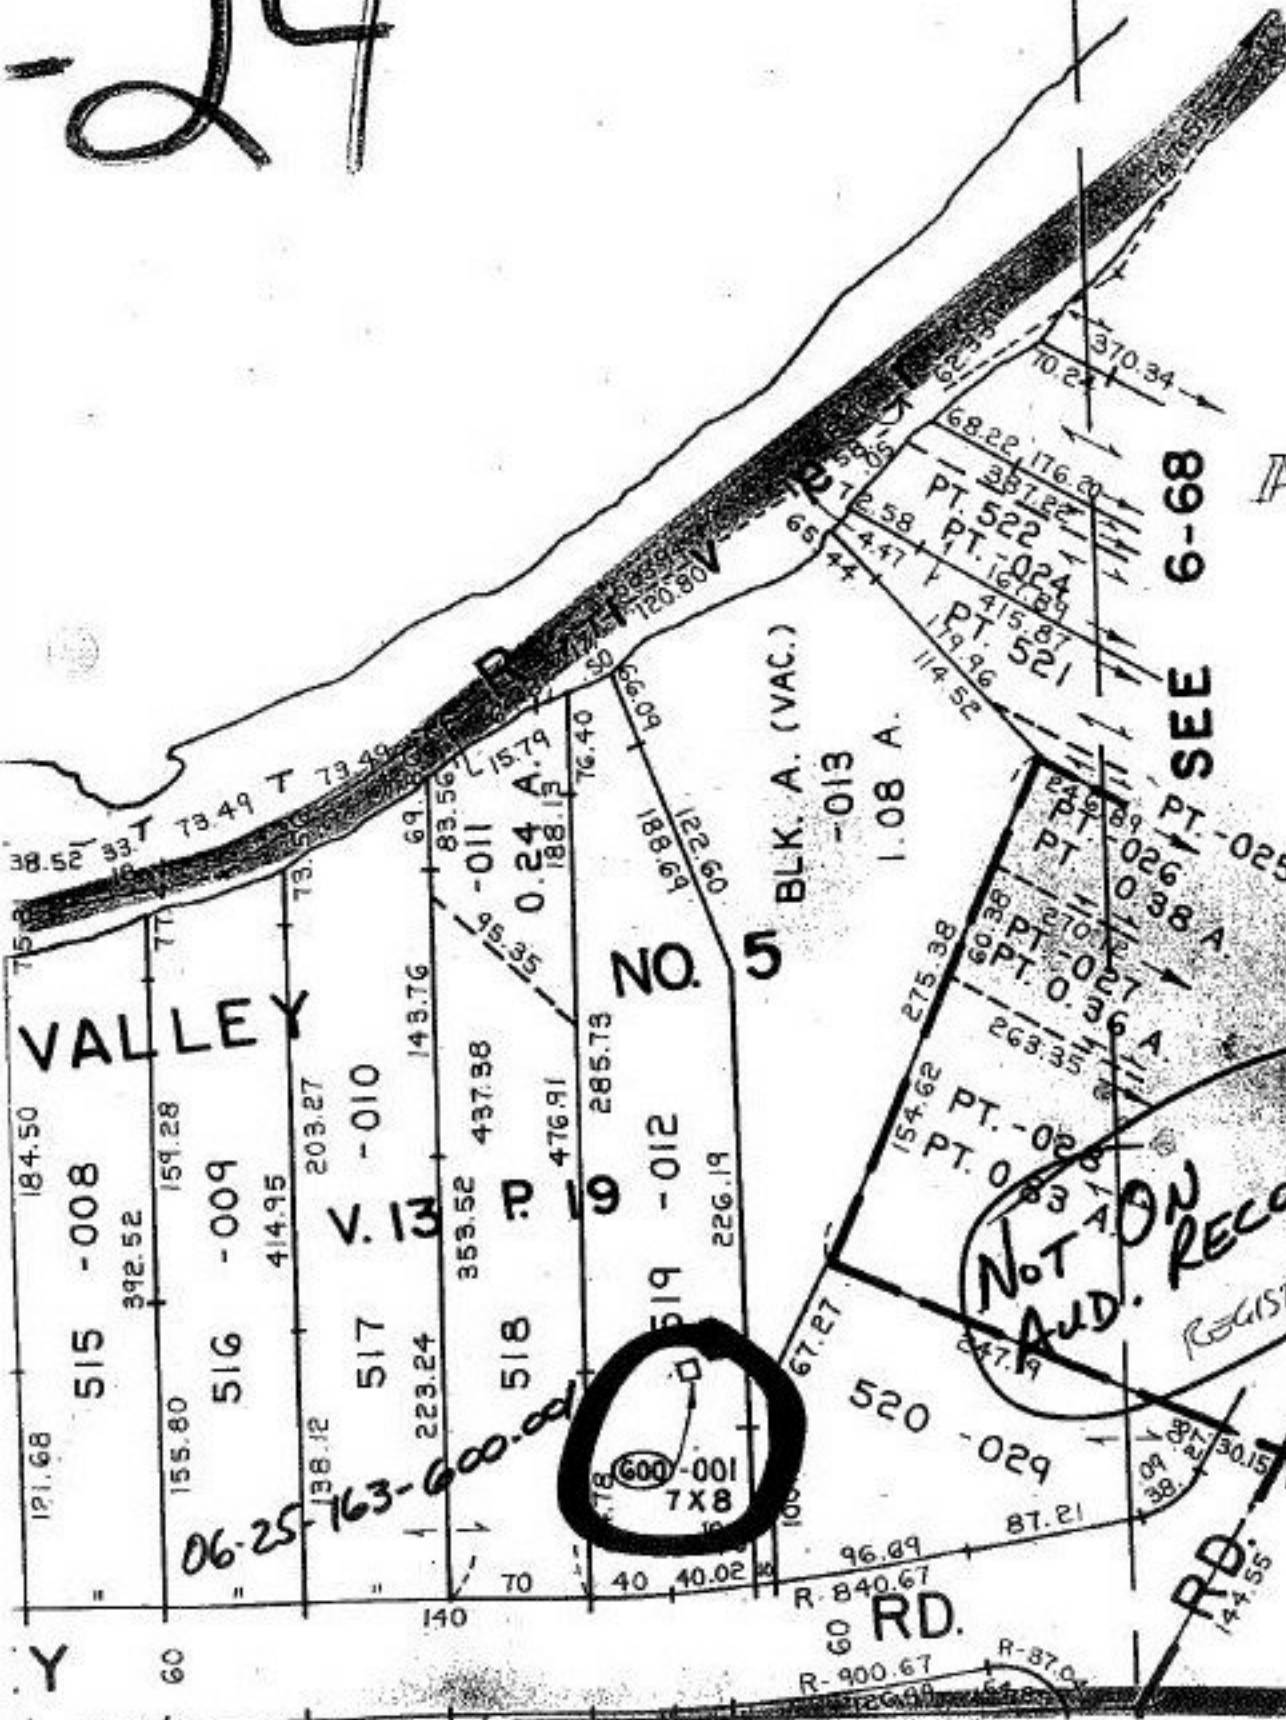

ADD TO DUP.

#21950-X

SEE 6-68

APPROVED
LORAIN CO.
MAP DEPT.
DATE 1-2-96
PAGE 6-67
BY T. McMain
NO. 21950-X

NOT ON RECORDS

REGISTER MAP

MP. 6-67

06-25-163-600-001

600-001 7X8

RD. 60

RD. 44