


#21950-X

18-00-028-114

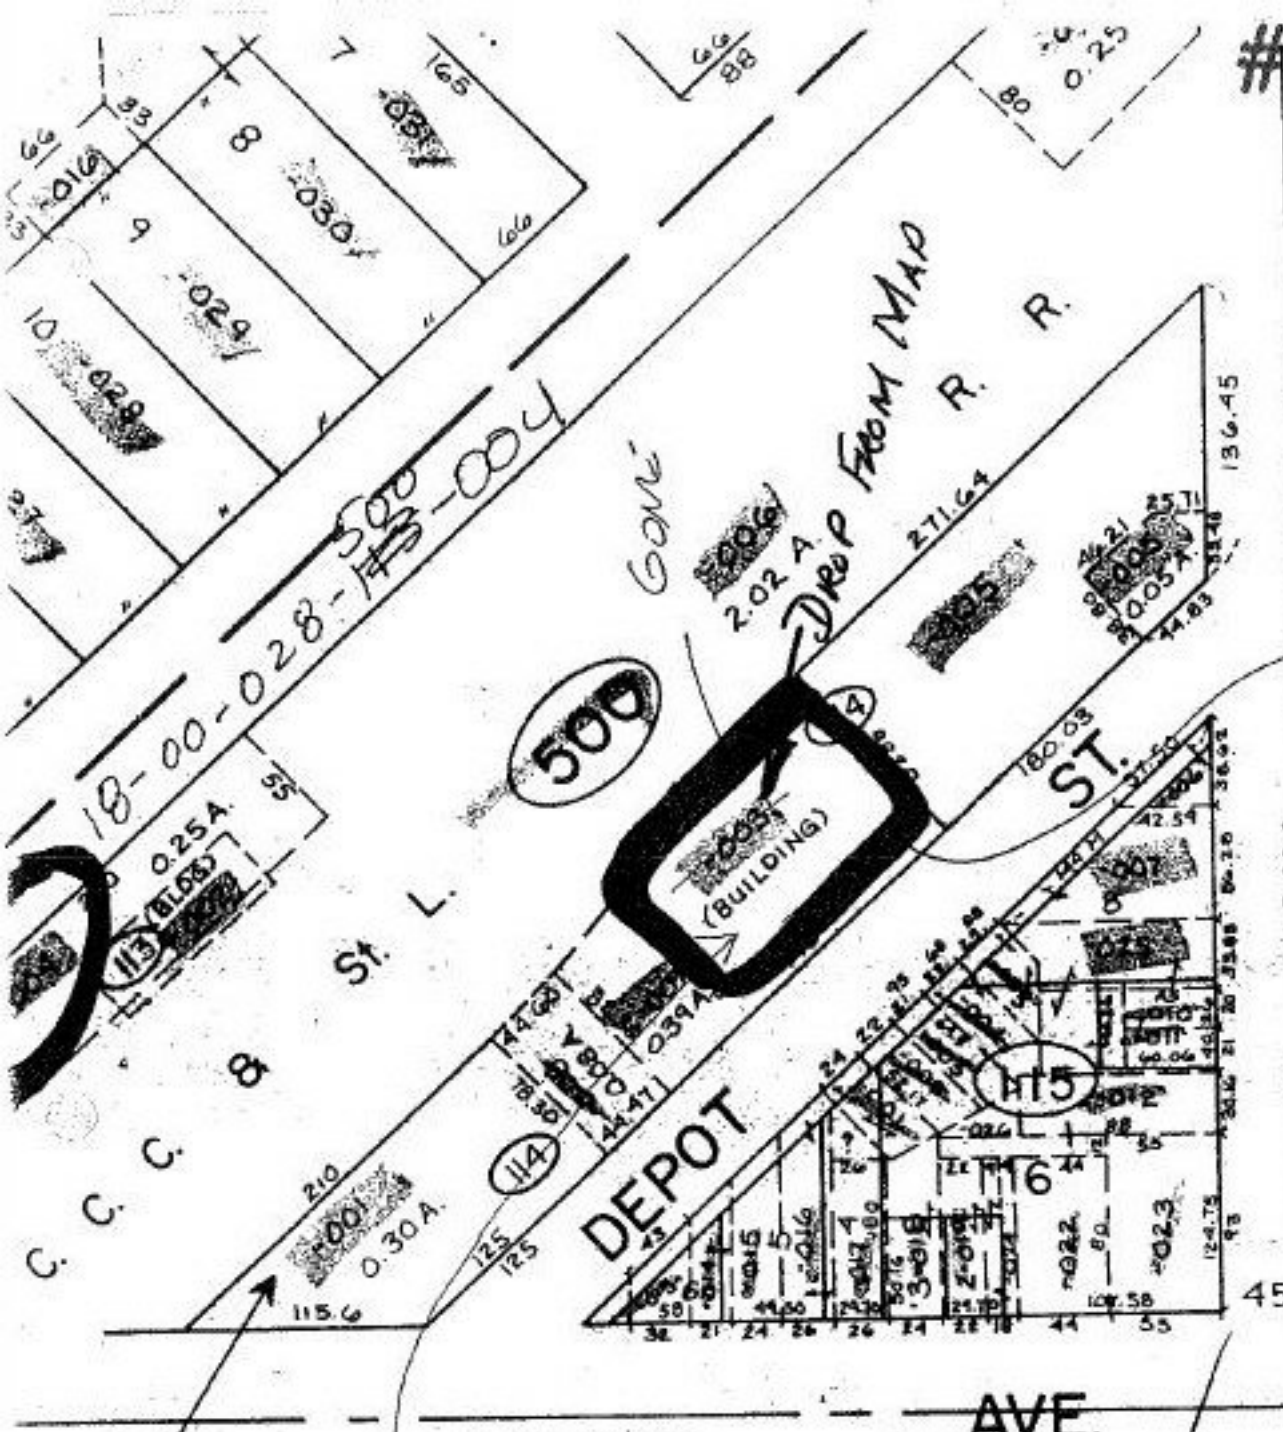

N. MAIN

18-00-028-114-003  
 DROP FROM DUP.  
 PER STEVE BIRCH

AVE.

6/24/96

Not on Dup.

250

21950-X

APPROVED	
LORAIN CO.	
MAP DEPT.	
DATE 12-9-96	
PAGE 18-00-028-D	
BY K.DYE	
WORD	# 21950-X
FILE #	

# WELLINGTON

REVISED 8/23/94

## 18-00-028-D

1/4 LOT 28