


#21952

SEE 5-00

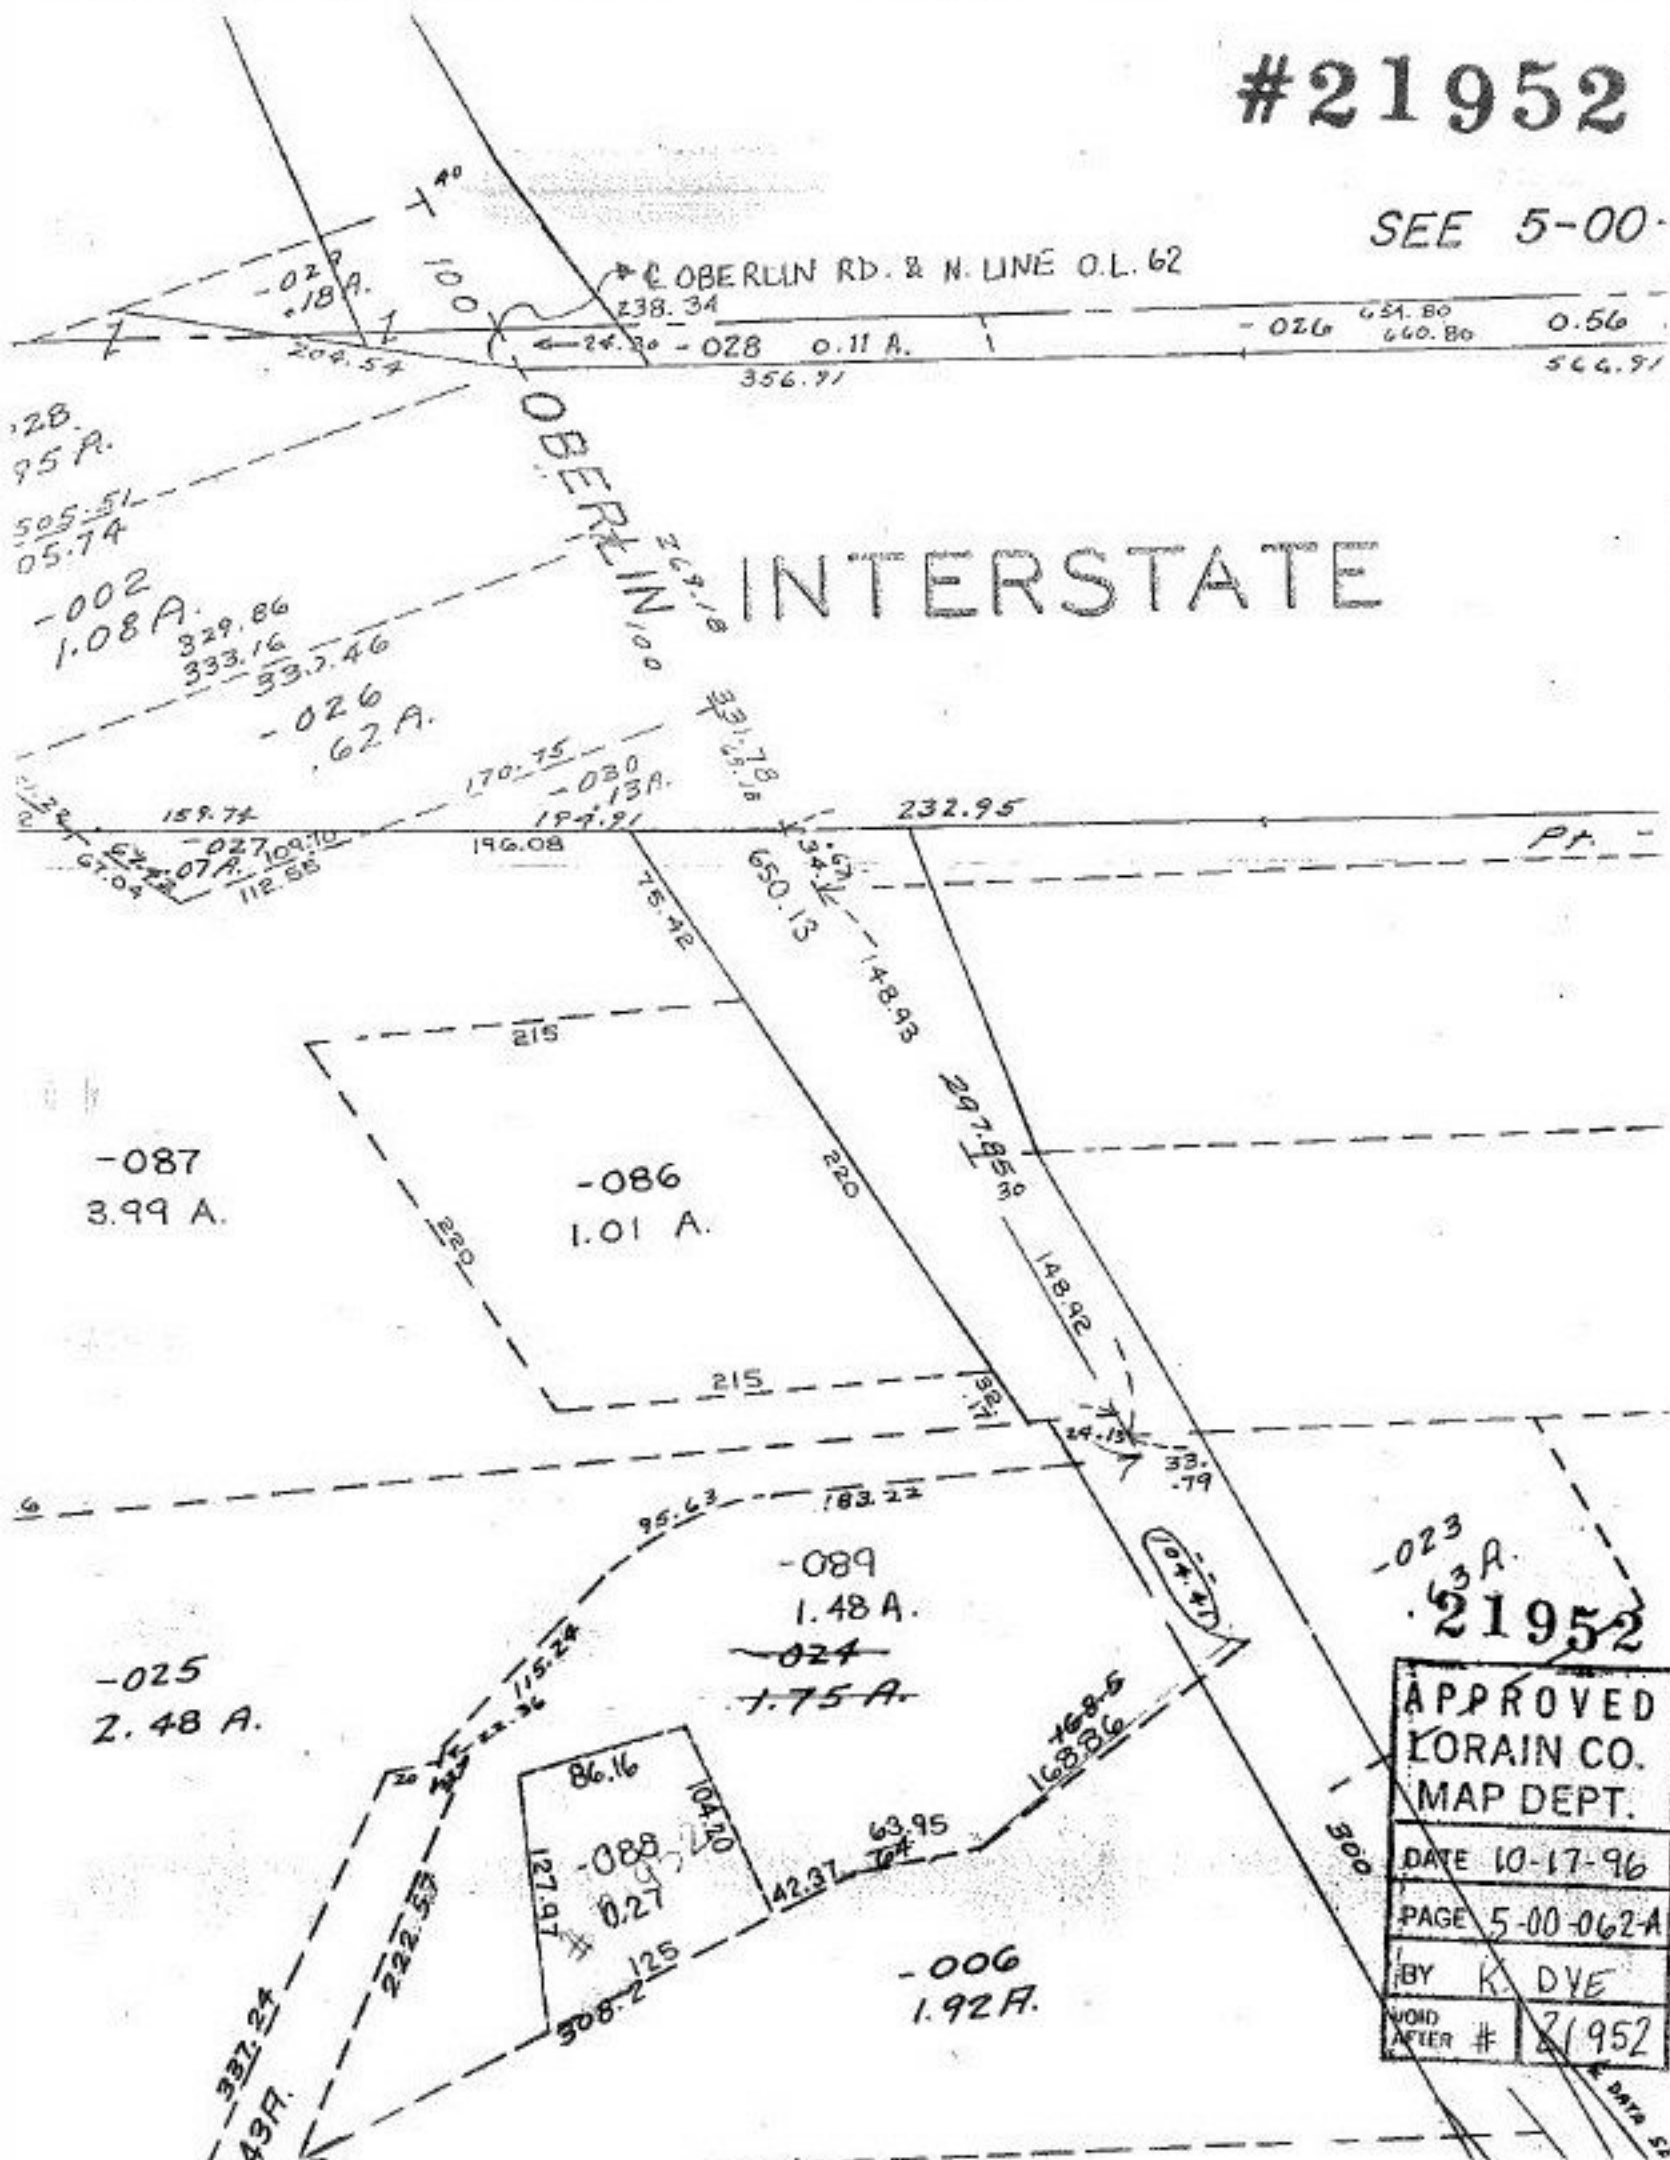

-023
 63 A.
 #21952

APPROVED	
LORAIN CO.	
MAP DEPT.	
DATE	10-17-96
PAGE	5-00-062-A
BY	K. DYE
VOID AFTER #	21952

DATA 52