


PARENT PARCEL: 11-00-008-000-039

CHILD PARCEL:

STARTING POINT: cl. of Hawke Rd. & cl. of Cooley Rd.

NO. 21954-D

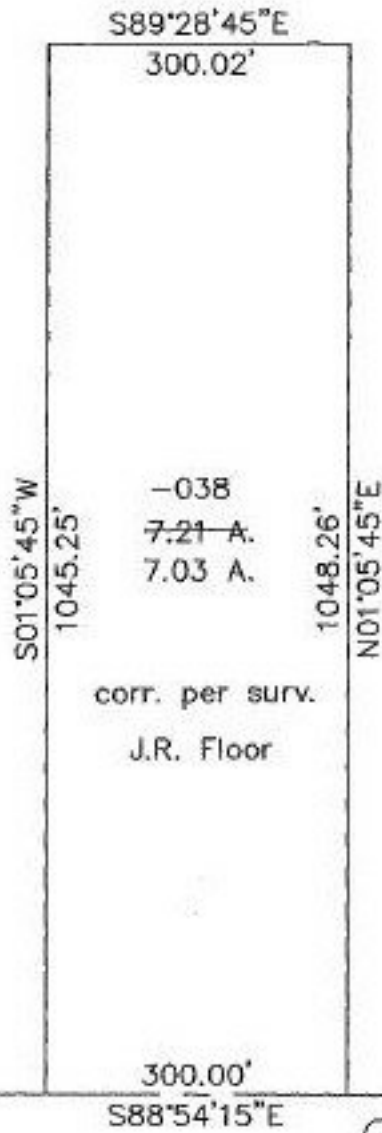

Ac. correction: see
OR 1215/877

Hawke Rd.

Cooley Rd.

1469.52'
N88°54'15"W



1-28-99

SPLITS/DEEDS PROCESSED
LORAIN COUNTY TAX MAP DEPARTMENT
226 MIDDLE AVE. ELYRIA, OHIO

SURVEYED BY: J.R. Floor
 CLOSURE: 0.75:10,000
 MAP PAGE(S): 11-00-008-A
 APPROVED BY: kac DATE: 4/3/98
 SCALE: 1" = 200' PRIOR INSTRUMENT: