


#21954

U10	44	-023
011	45	-024
012	46	-025
013	47	-026
2-3	48	-027
015	49	-028
001	50	-010
002	51	-011
003	52	-012
004	53	-013
005	54	-014
006	55	-015
007	56	-017
008	57	-018
009	58	-019
61	021	
60	-022	
59	-023	

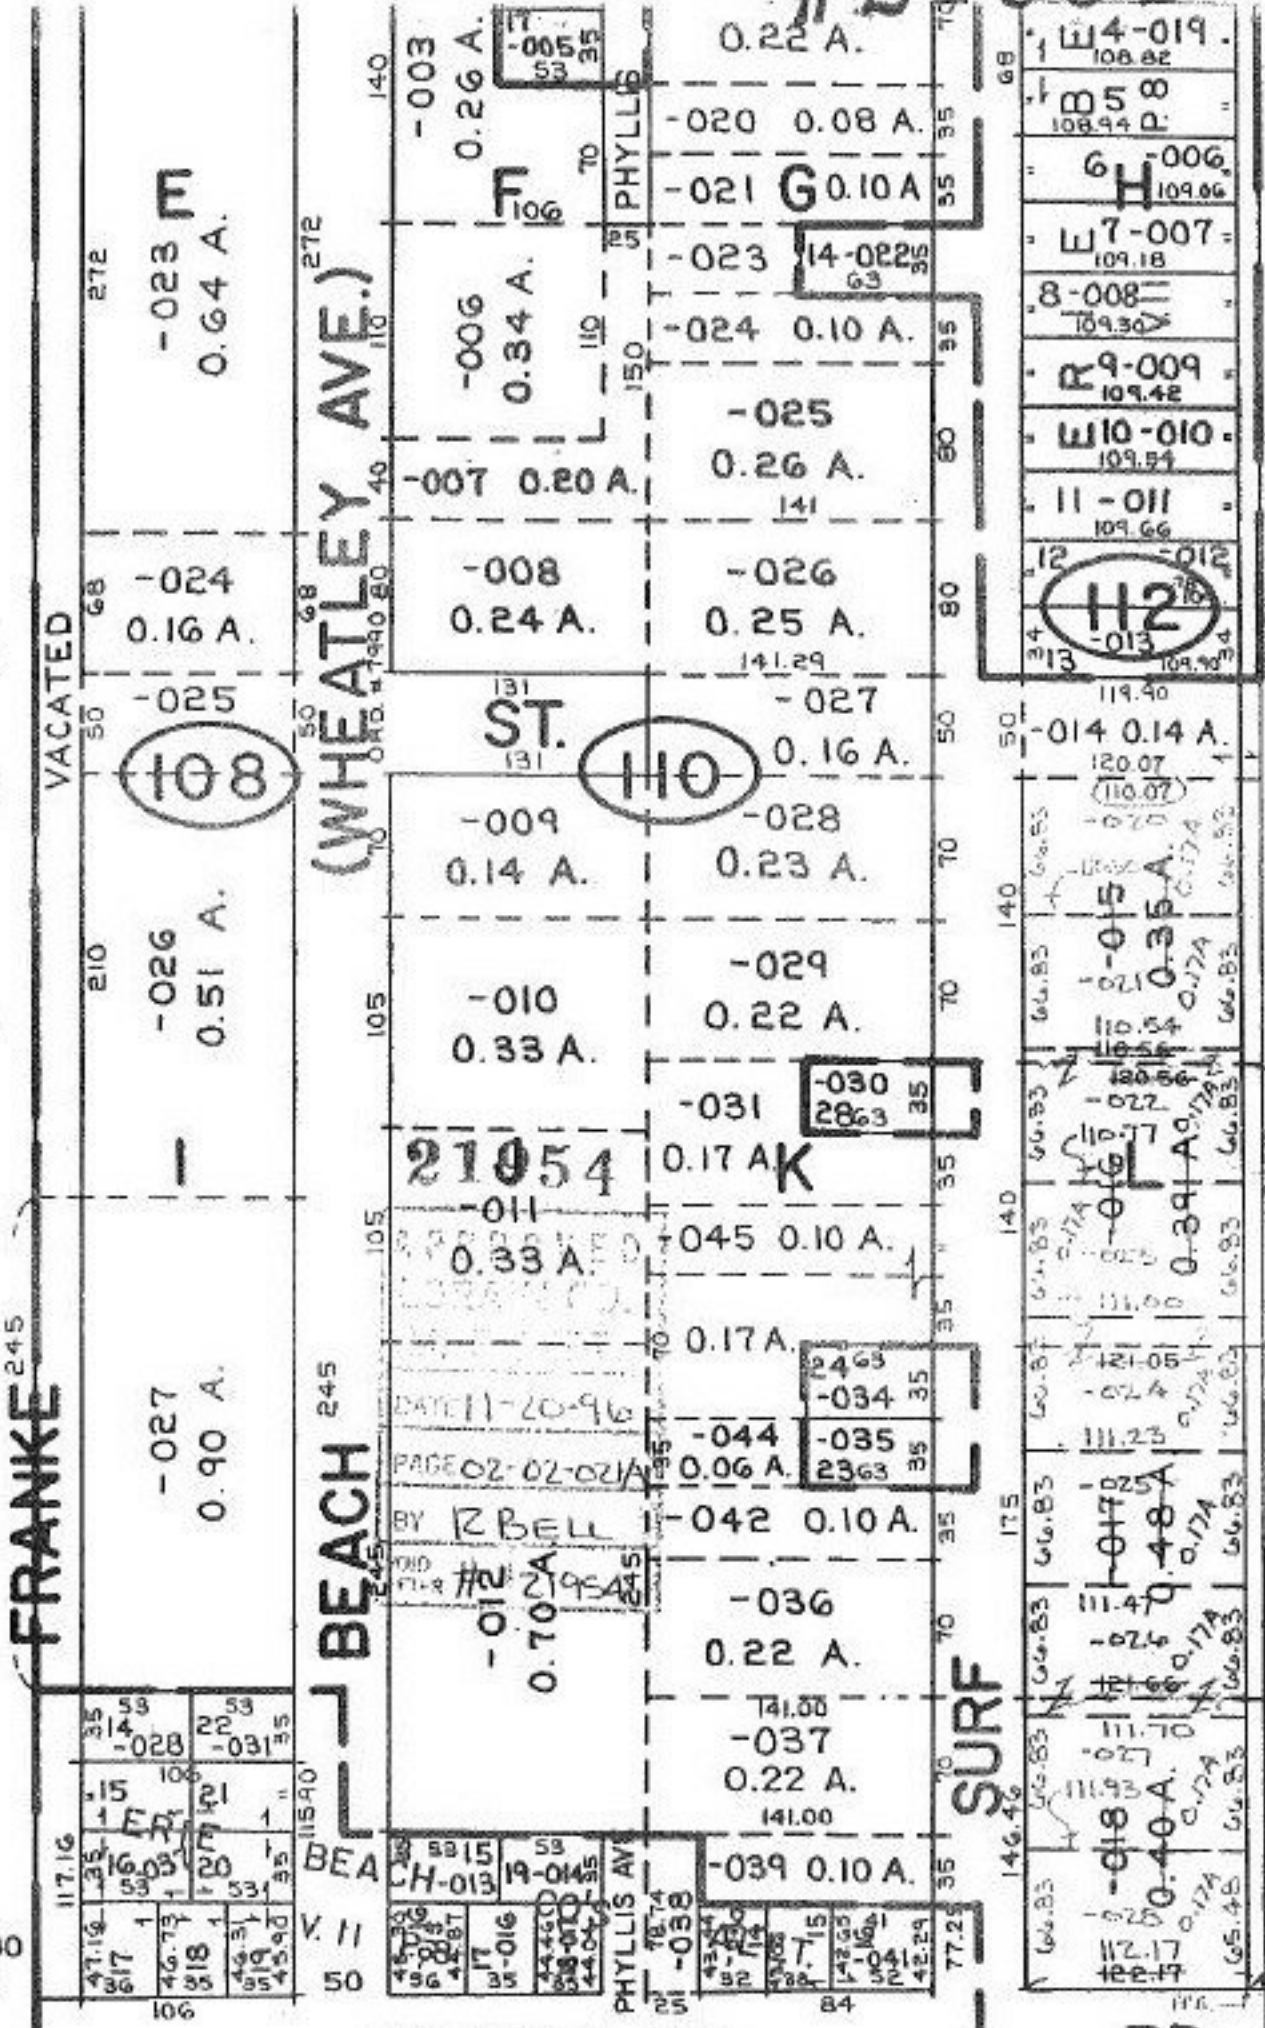

MEISTER RD

POB