


#21956

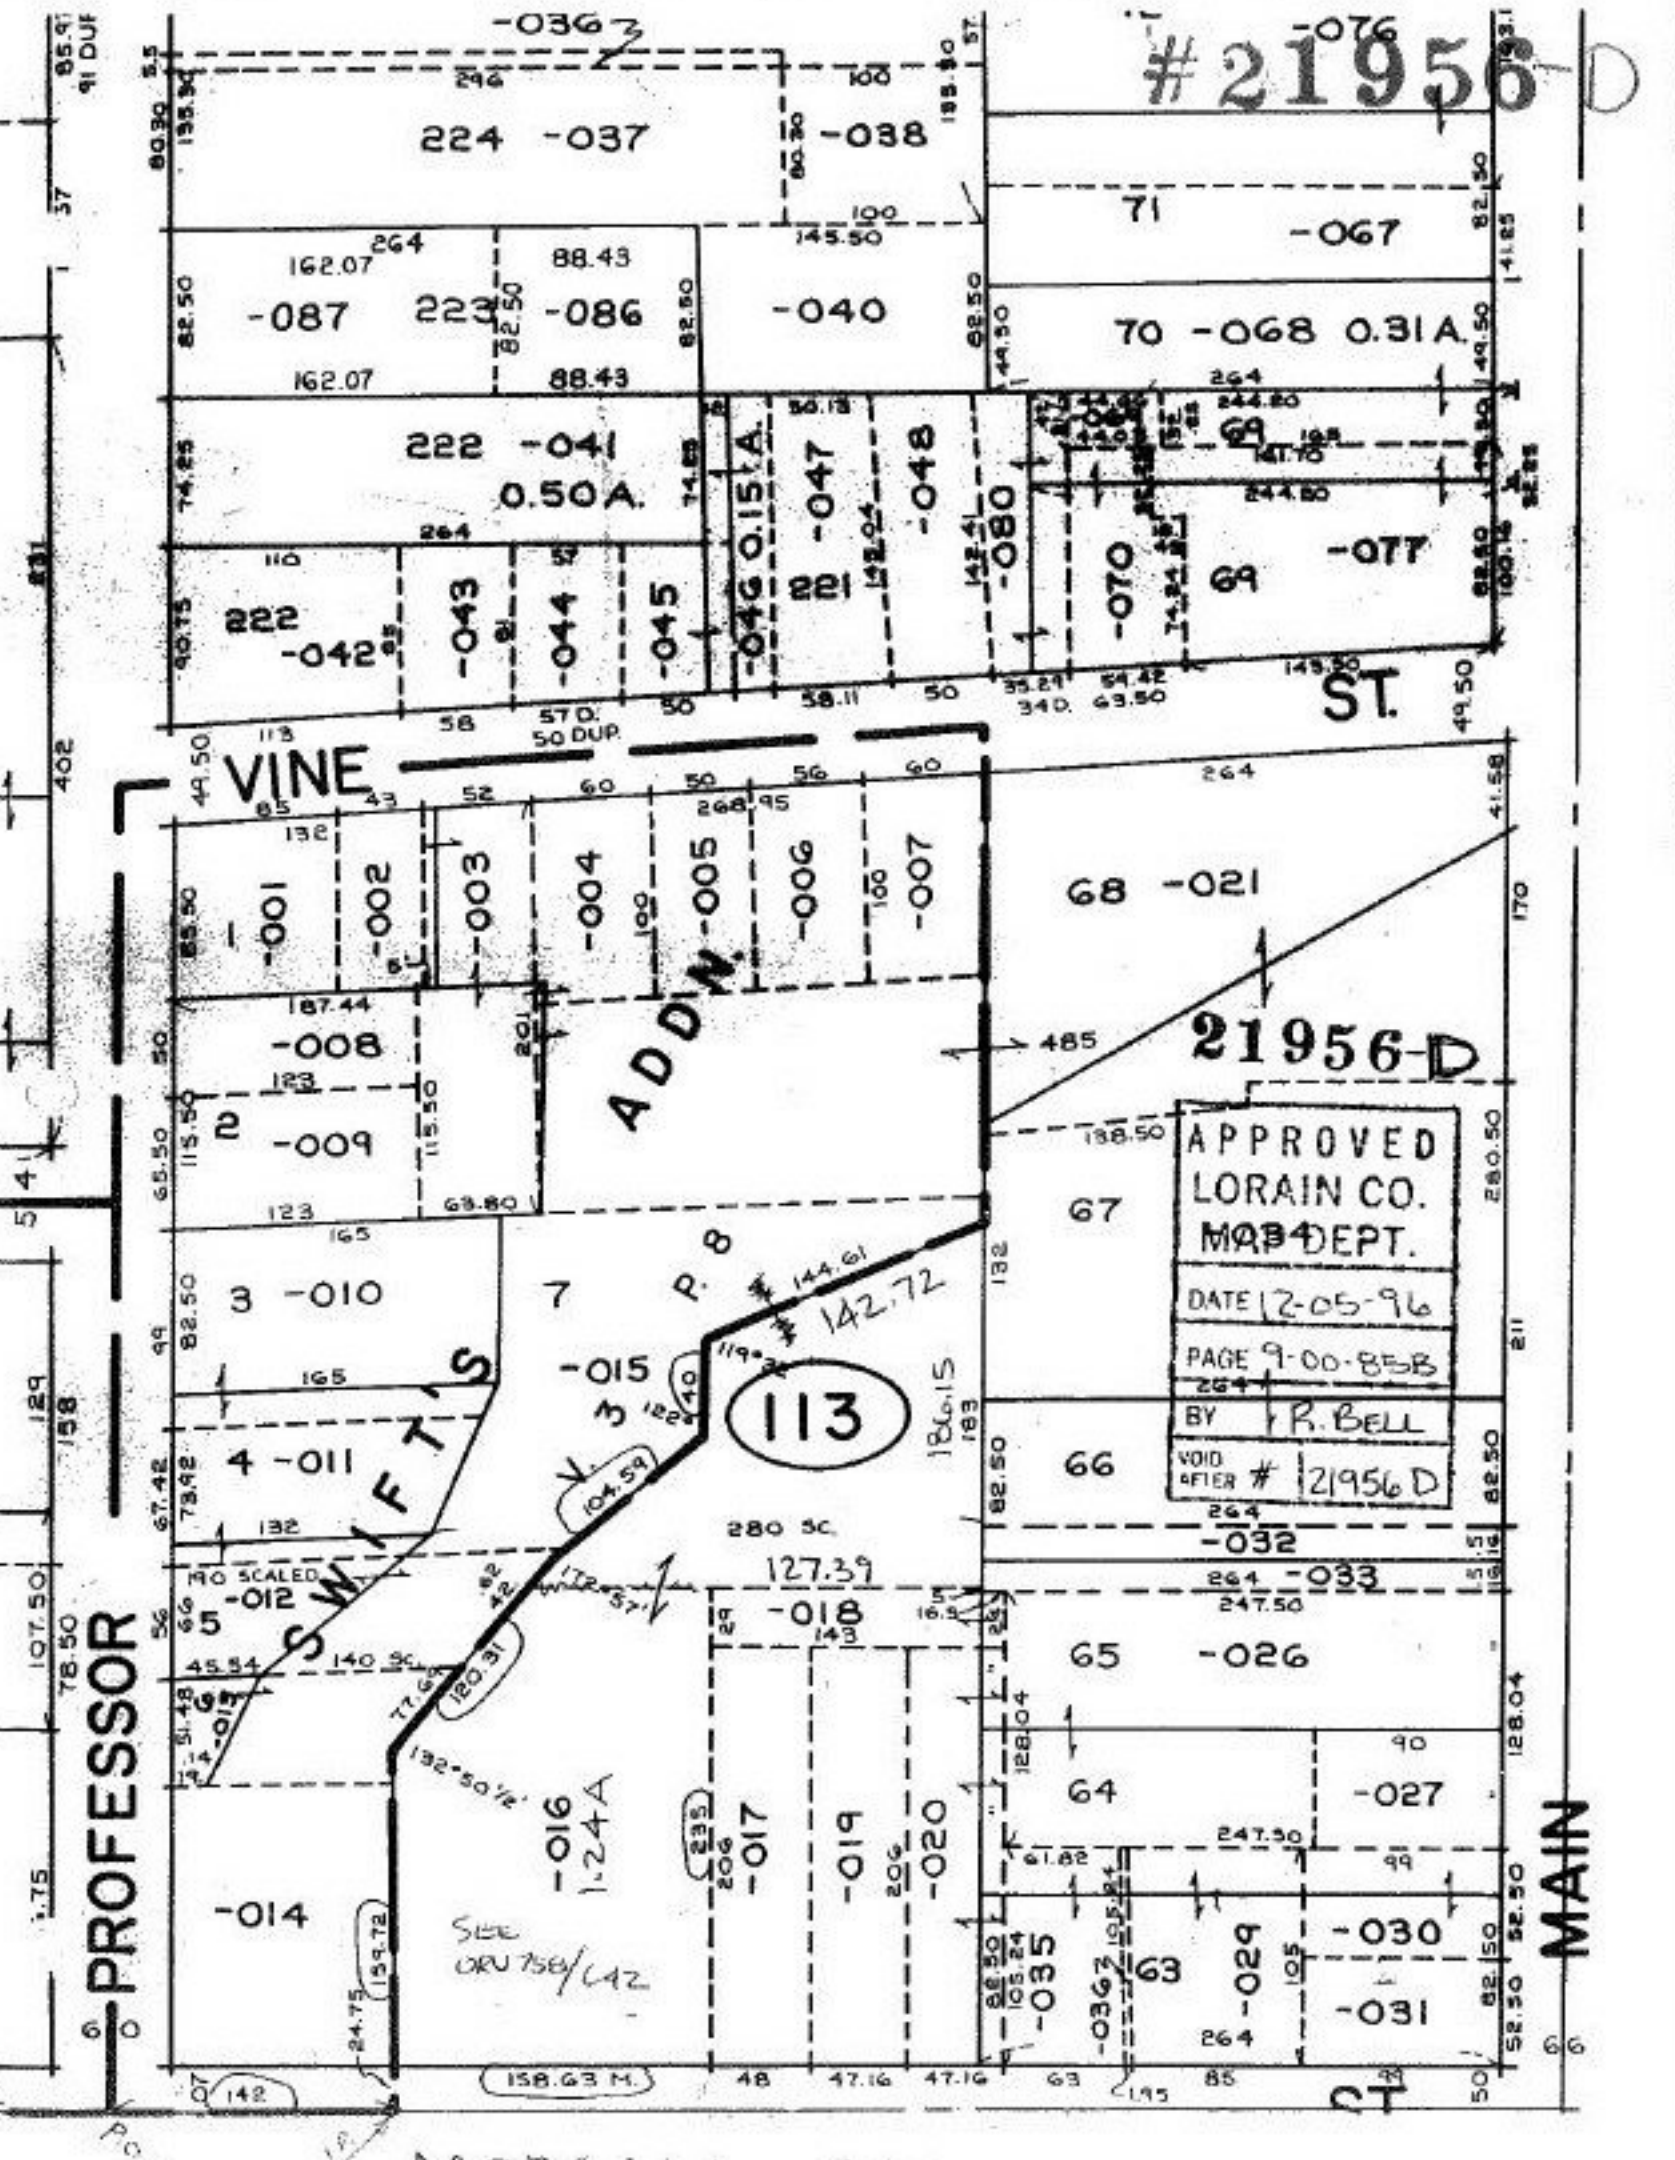

VINE

ST.

ADDN.

21956-D

APPROVED
LORAIN CO.
MAP DEPT.
DATE 12-05-96
PAGE 9-00-85-B
BY R. BELL
VOID AFTER # 21956D

113

PROFESSOR

SWIFT'S

MAIN

SEE ORU 758/42

