


#21962

21962

APPROVED
 LORAIN CO.
 MAP DEPT.
 DATE 11-19-96
 PAGE 6-131
 BY R BELL
 V. # 21962

PT. - 035
PT. 40.06 A.

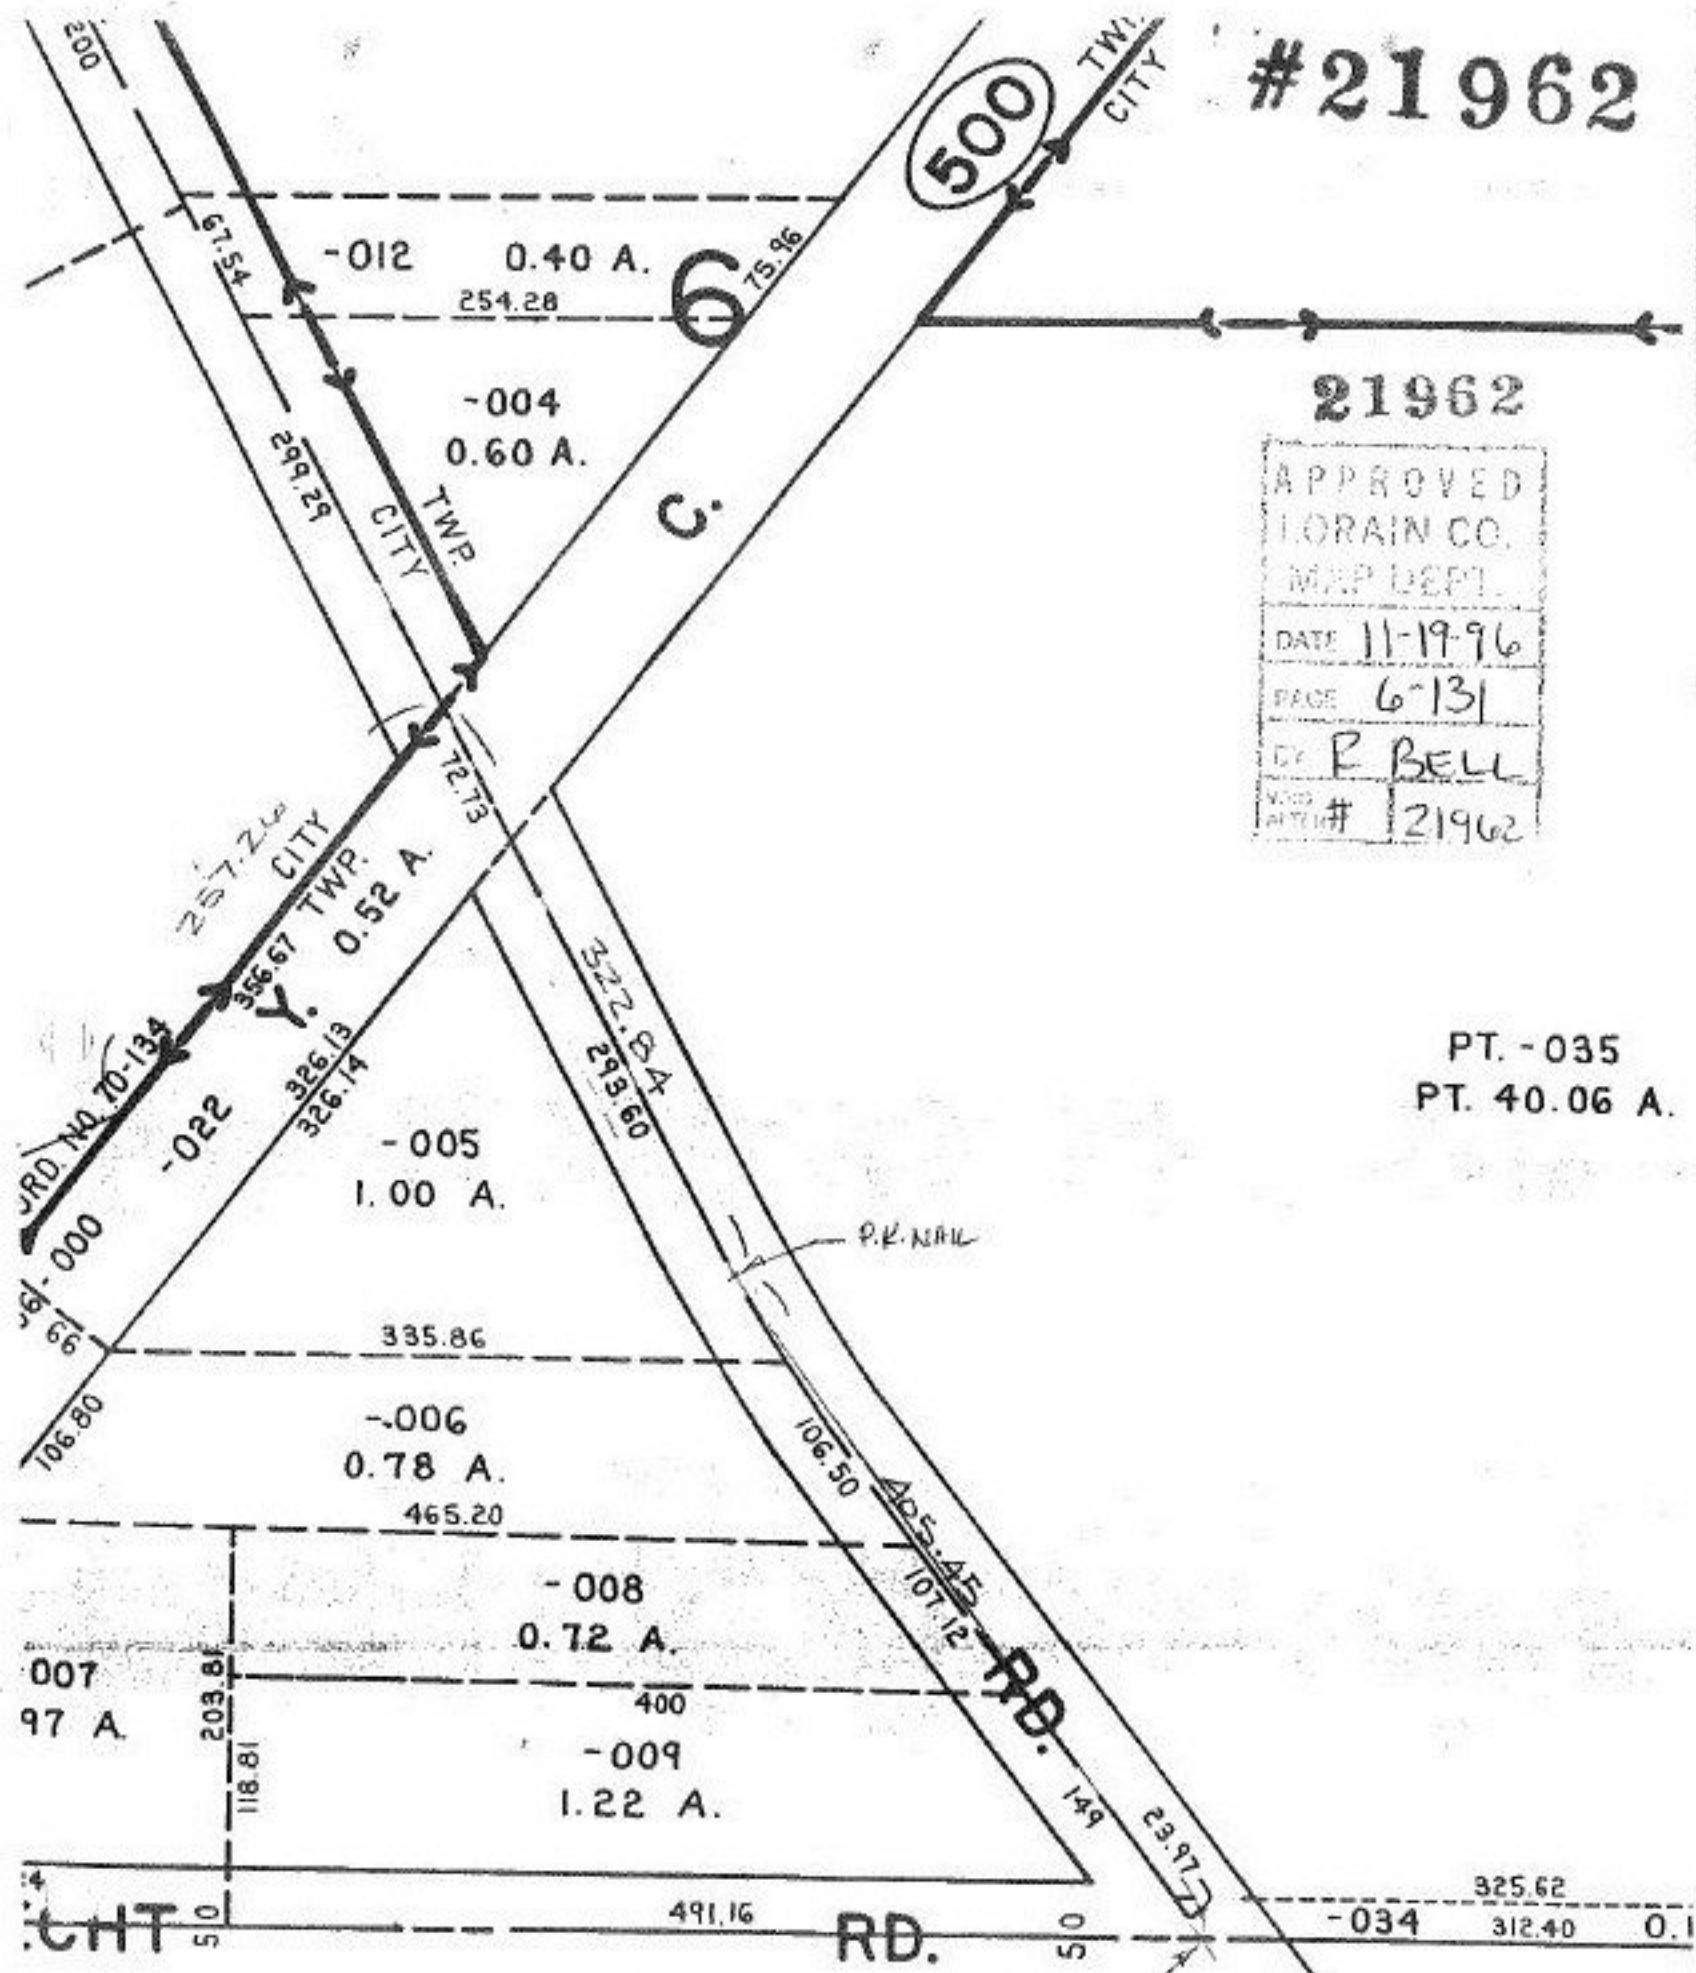

SEE 10-B

I.P.