

- 001  
21.29 A.

#21964

105

SEE 5-00-043-A

21964

APPROVED  
LORAIN CO.  
MAP DEPT.


DATE: 11-6-96

PAGE: 500-047-B

BY: R. DYE

NO: #21964

SEE DETAIL (ATTACHED)

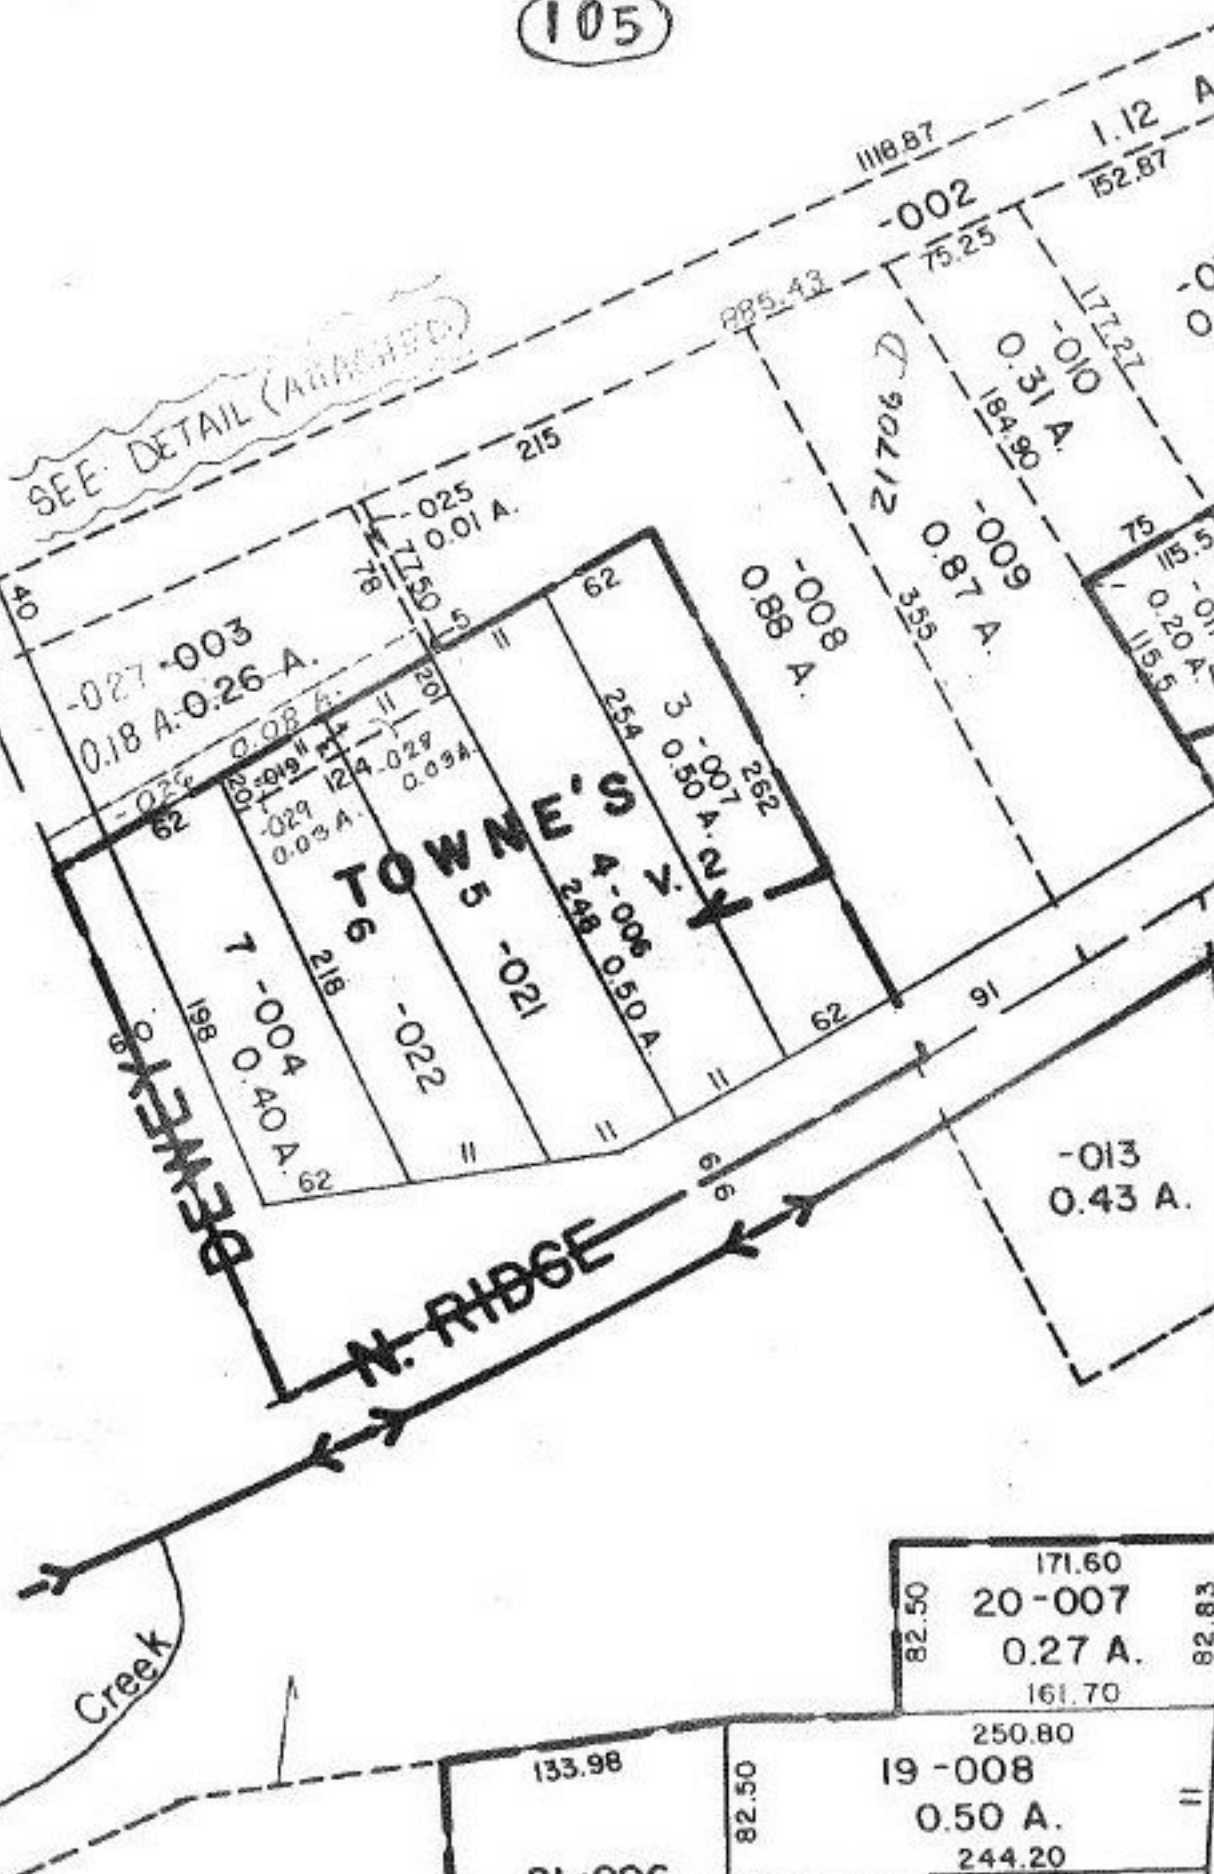

82.50	171.60	82.83
	20-007	
	0.27 A.	
	161.70	

133.98	250.80	
	19-008	
	0.50 A.	
	244.20	
21-006		

Reover