


#21966

SEE

VERMILION  
LORAIN CITY

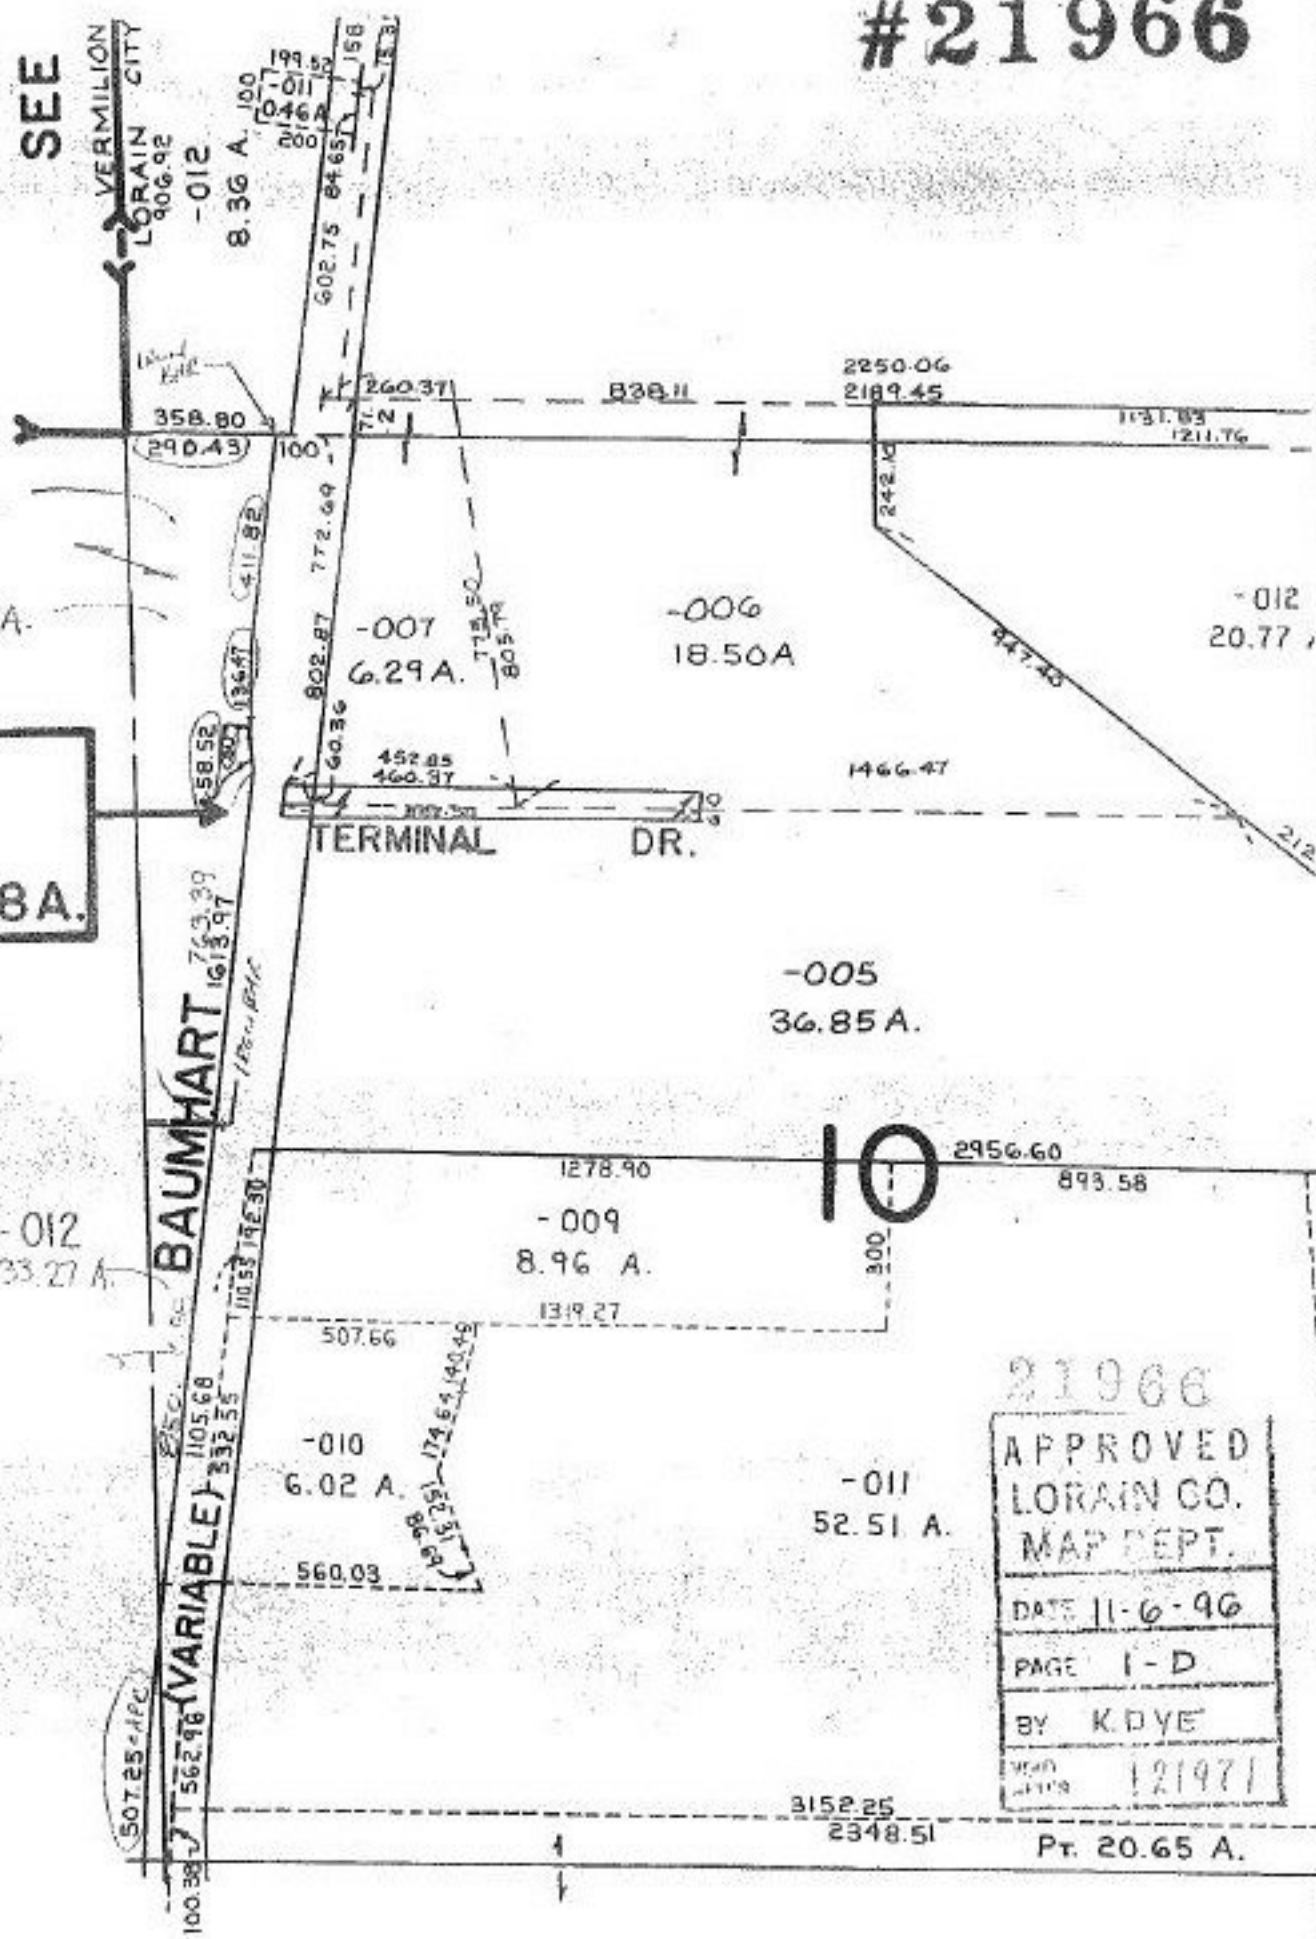

-010  
71.98 A.  
Pt. -01  
Pt. 33.21 A.

**DRIVE  
DEDICATION**  
900 -001 1.08 A.

Pt. -012  
Pt. 33.27 A.

21966  
APPROVED  
LORAIN CO.  
MAP DEPT.  
DATE 11-6-96  
PAGE 1-D  
BY K DYE  
121971

Pt. 20.65 A.