


#21966

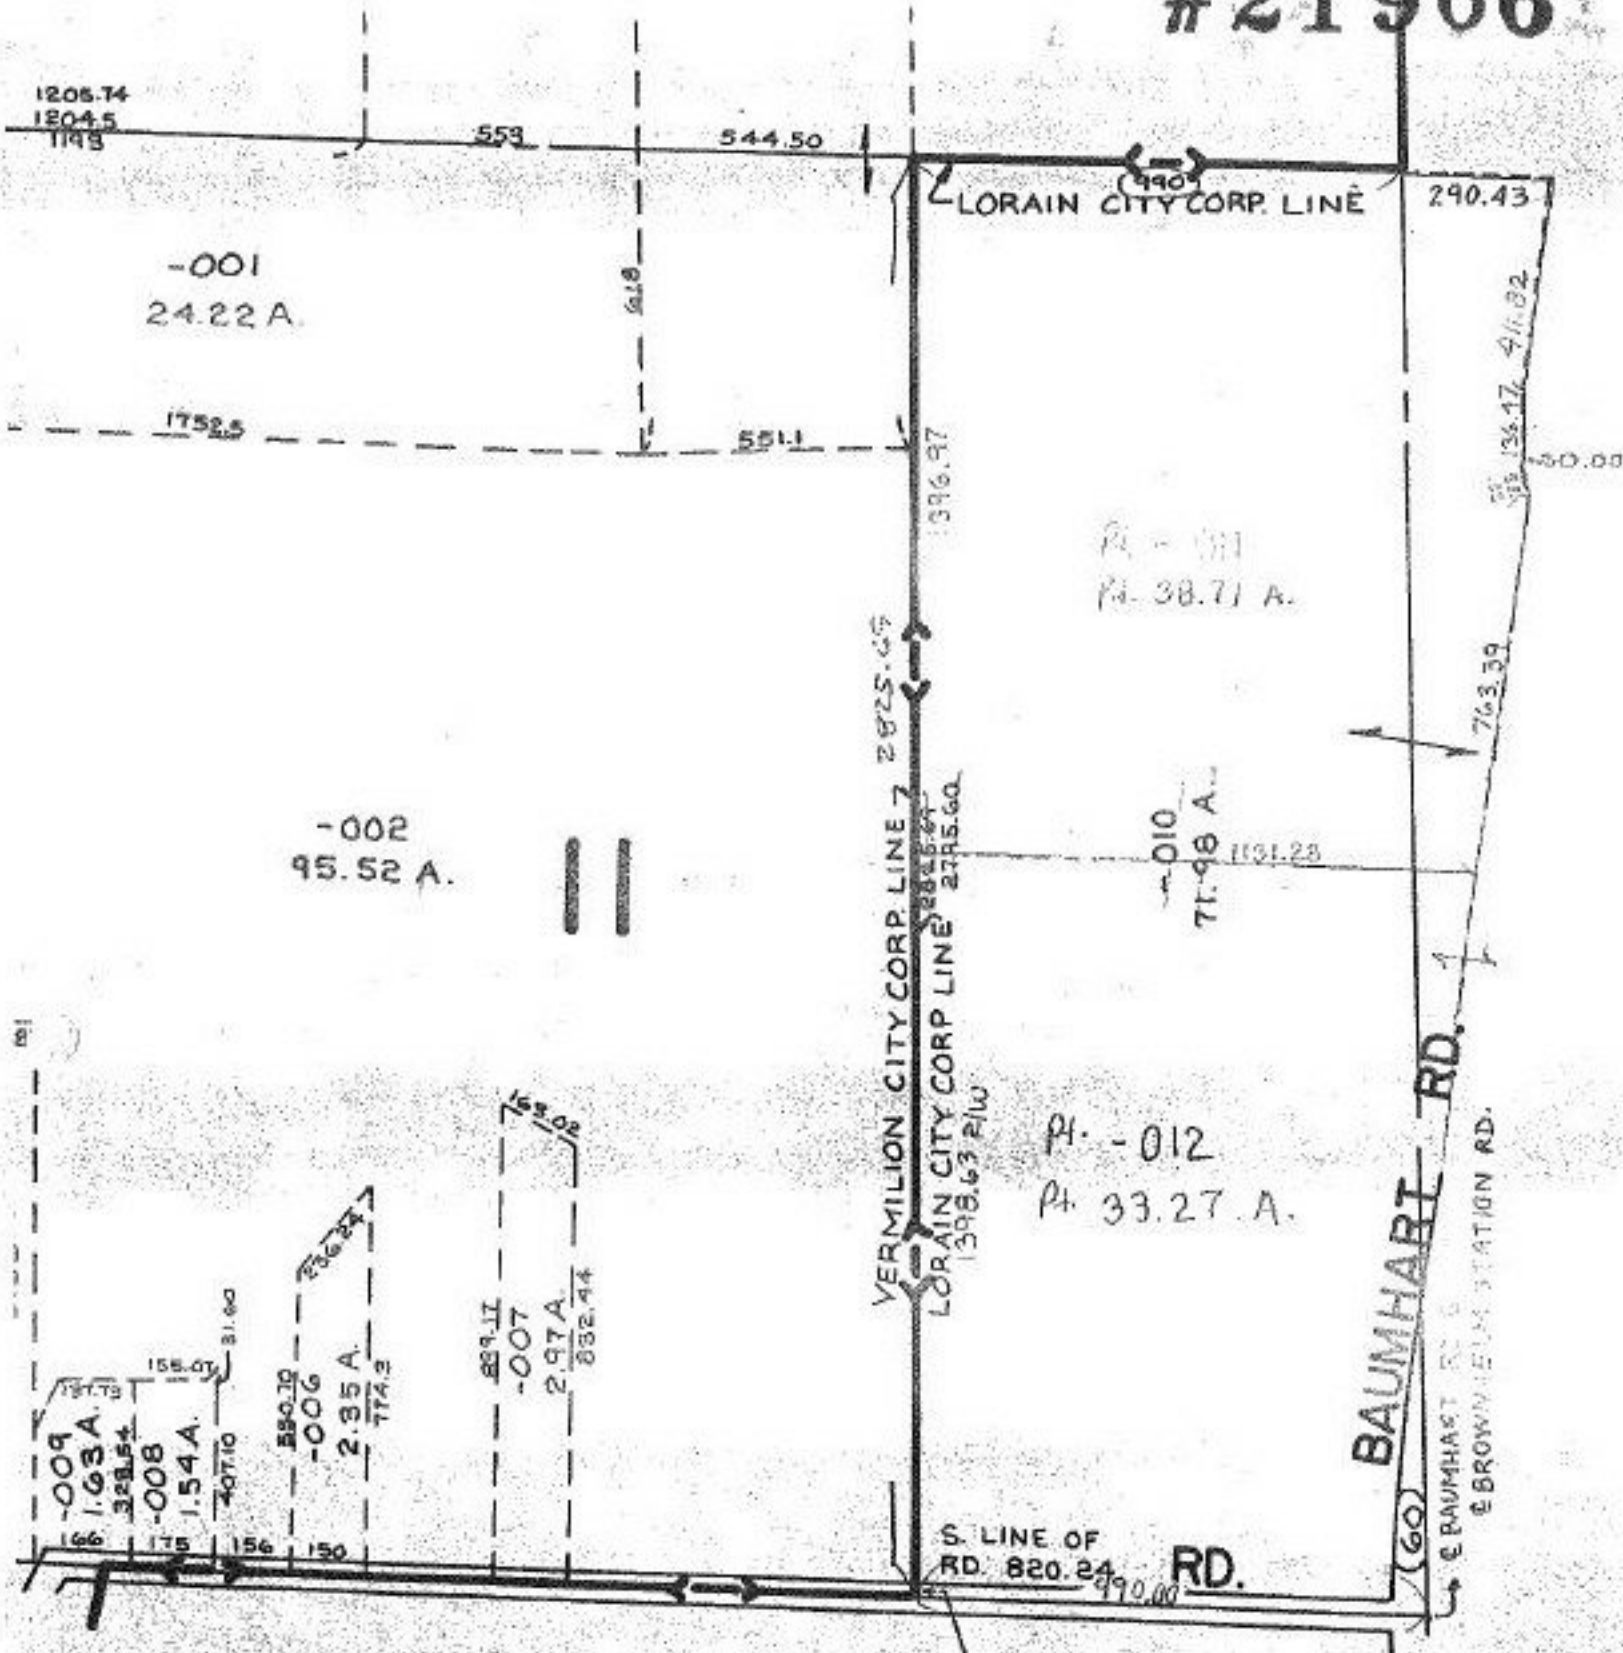

21966

APPROVED	
LORAIN CO.	
MAP DEPT	
DATE 11-6-16	
PAGE 1-C	
BY K. DYE	
NO. 21966	21971