


#21982

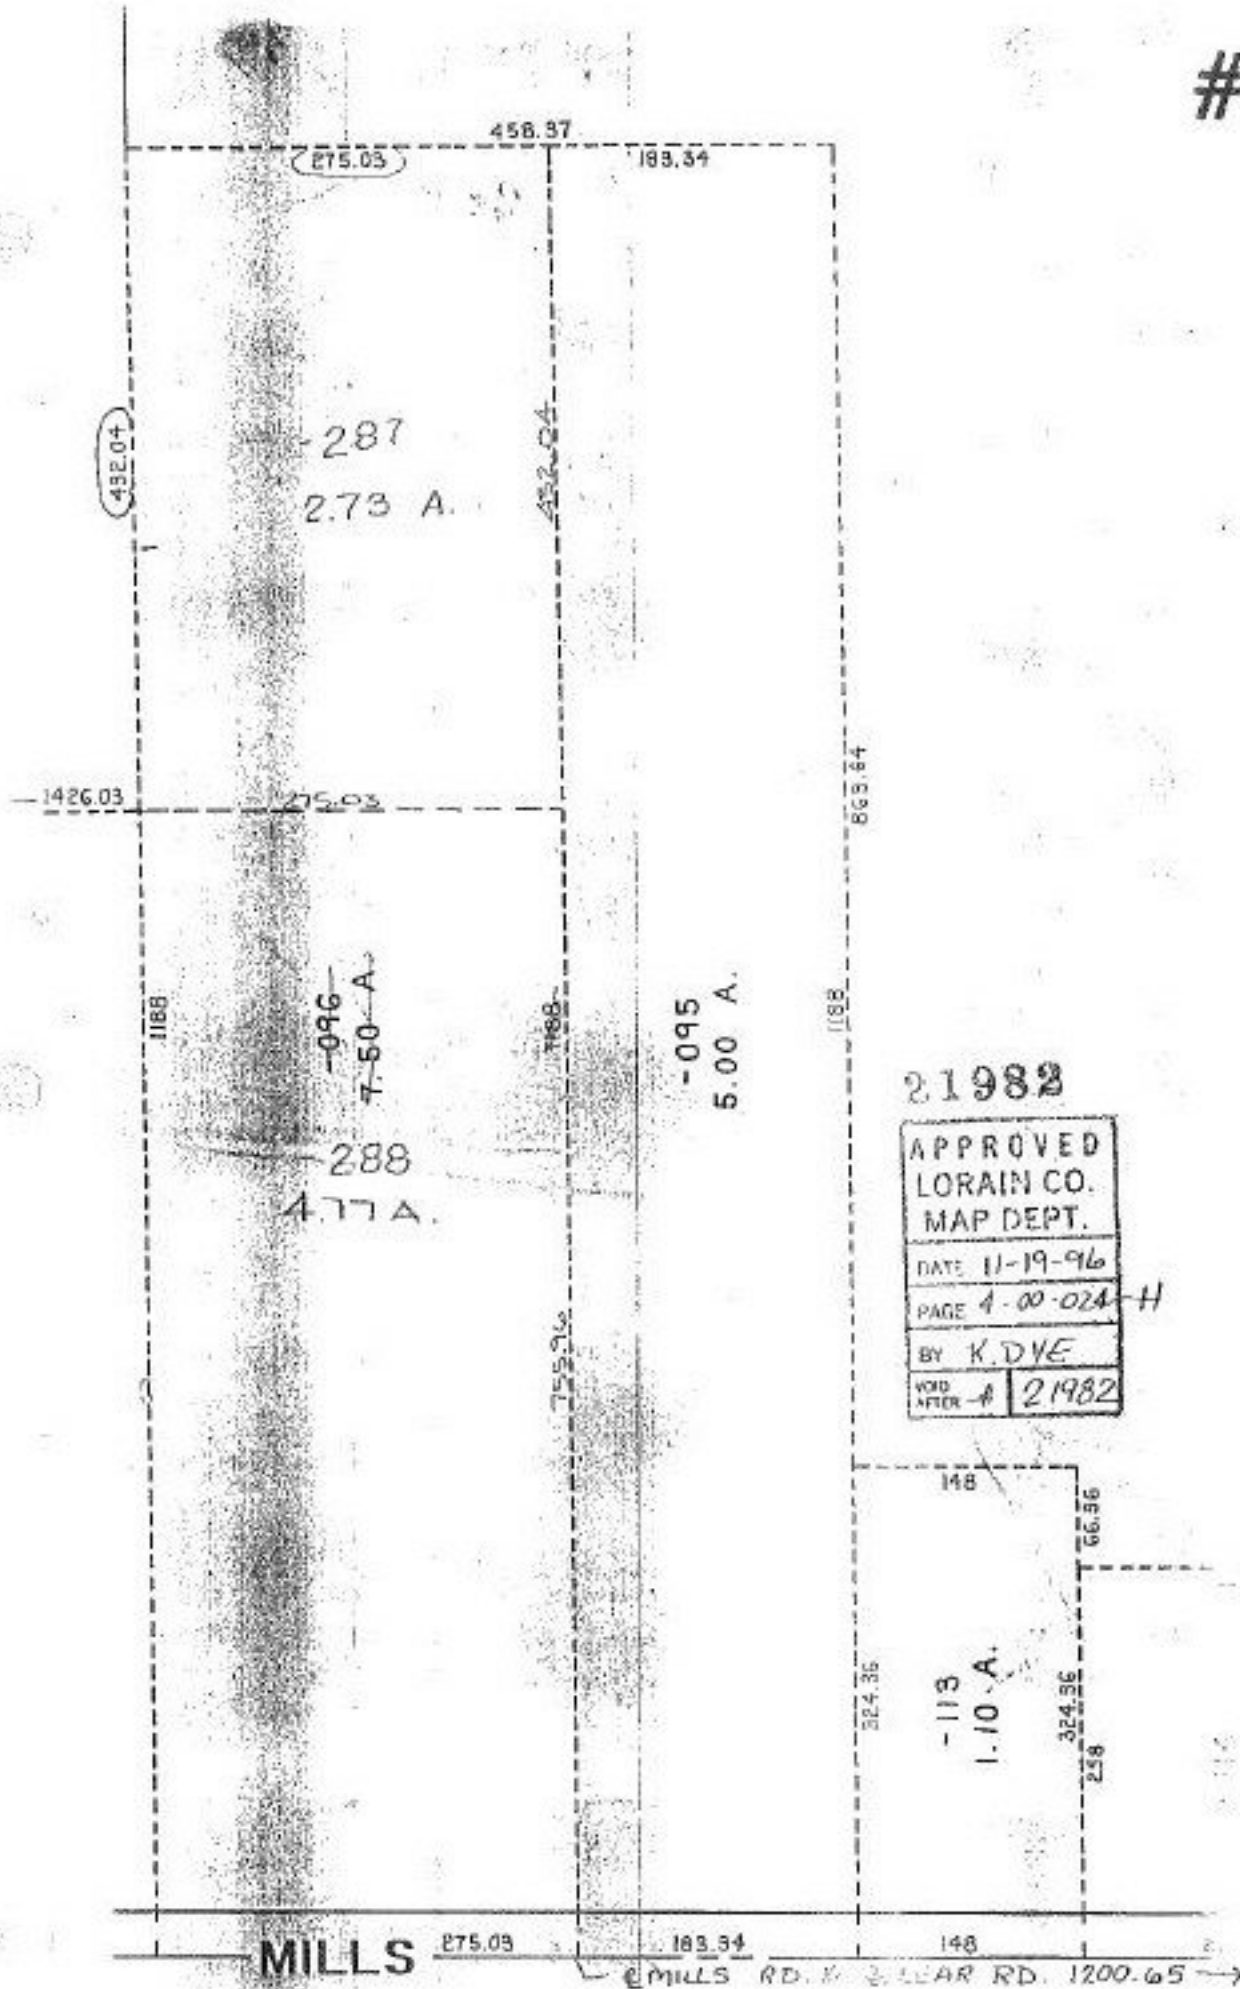

21982

APPROVED
LORAIN CO.
MAP DEPT.
DATE 11-19-96
PAGE 4-00-02A-H
BY K. DYE
VOID AFTER 21982