



#21991

NO. 21991

PARENT PARCEL: 05-00-082-000-024

CHILD PARCEL: 05-00-082-000-026

STARTING POINT: IP FD @ INT CL MIDDLE RIDGE RD & CL RELO WEST RIDGE RD

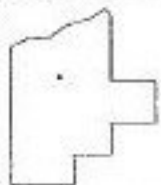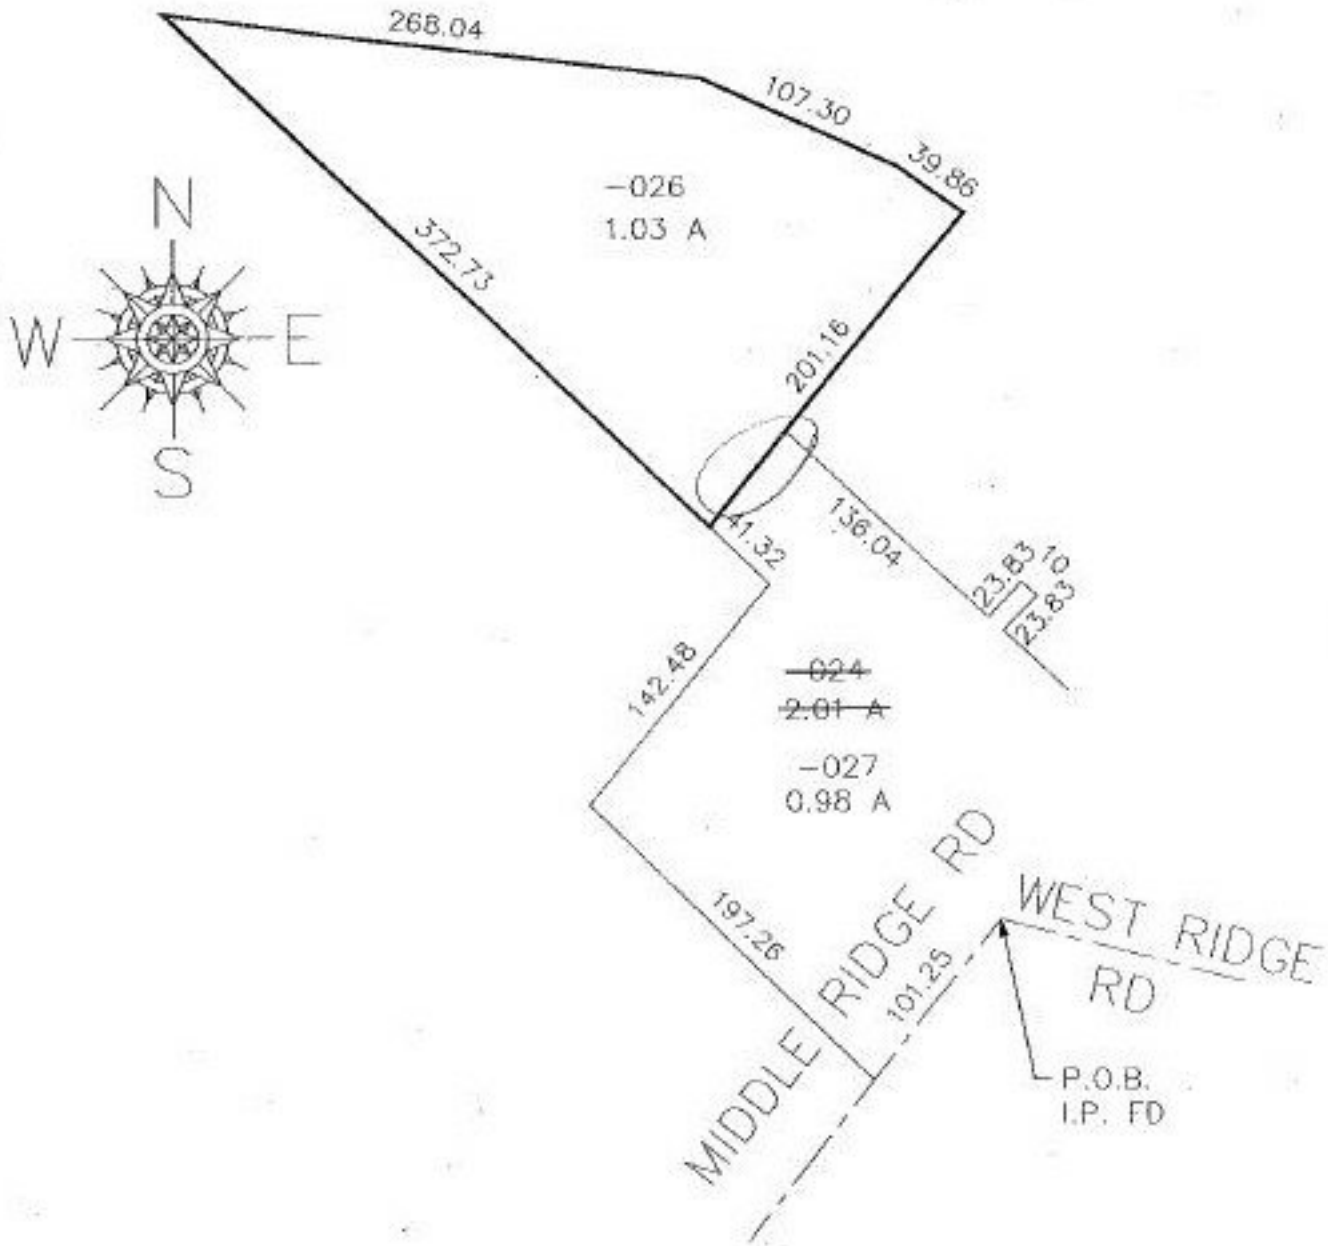

SPLITS/DEEDS PROCESSED

LORAIN COUNTY TAX MAP DEPARTMENT
226 MIDDLE AVE. ELYRIA, OHIO

SURVEYED BY: RODGER C. SIMON

CLOSURE: 0.16 : 10.000

MAP PAGE(S): 5-082

APPROVED BY: REB DATE: 03/10/97

SCALE: 1" = 100'