


DEBRA

SUB DR.

P. 59 21992-X

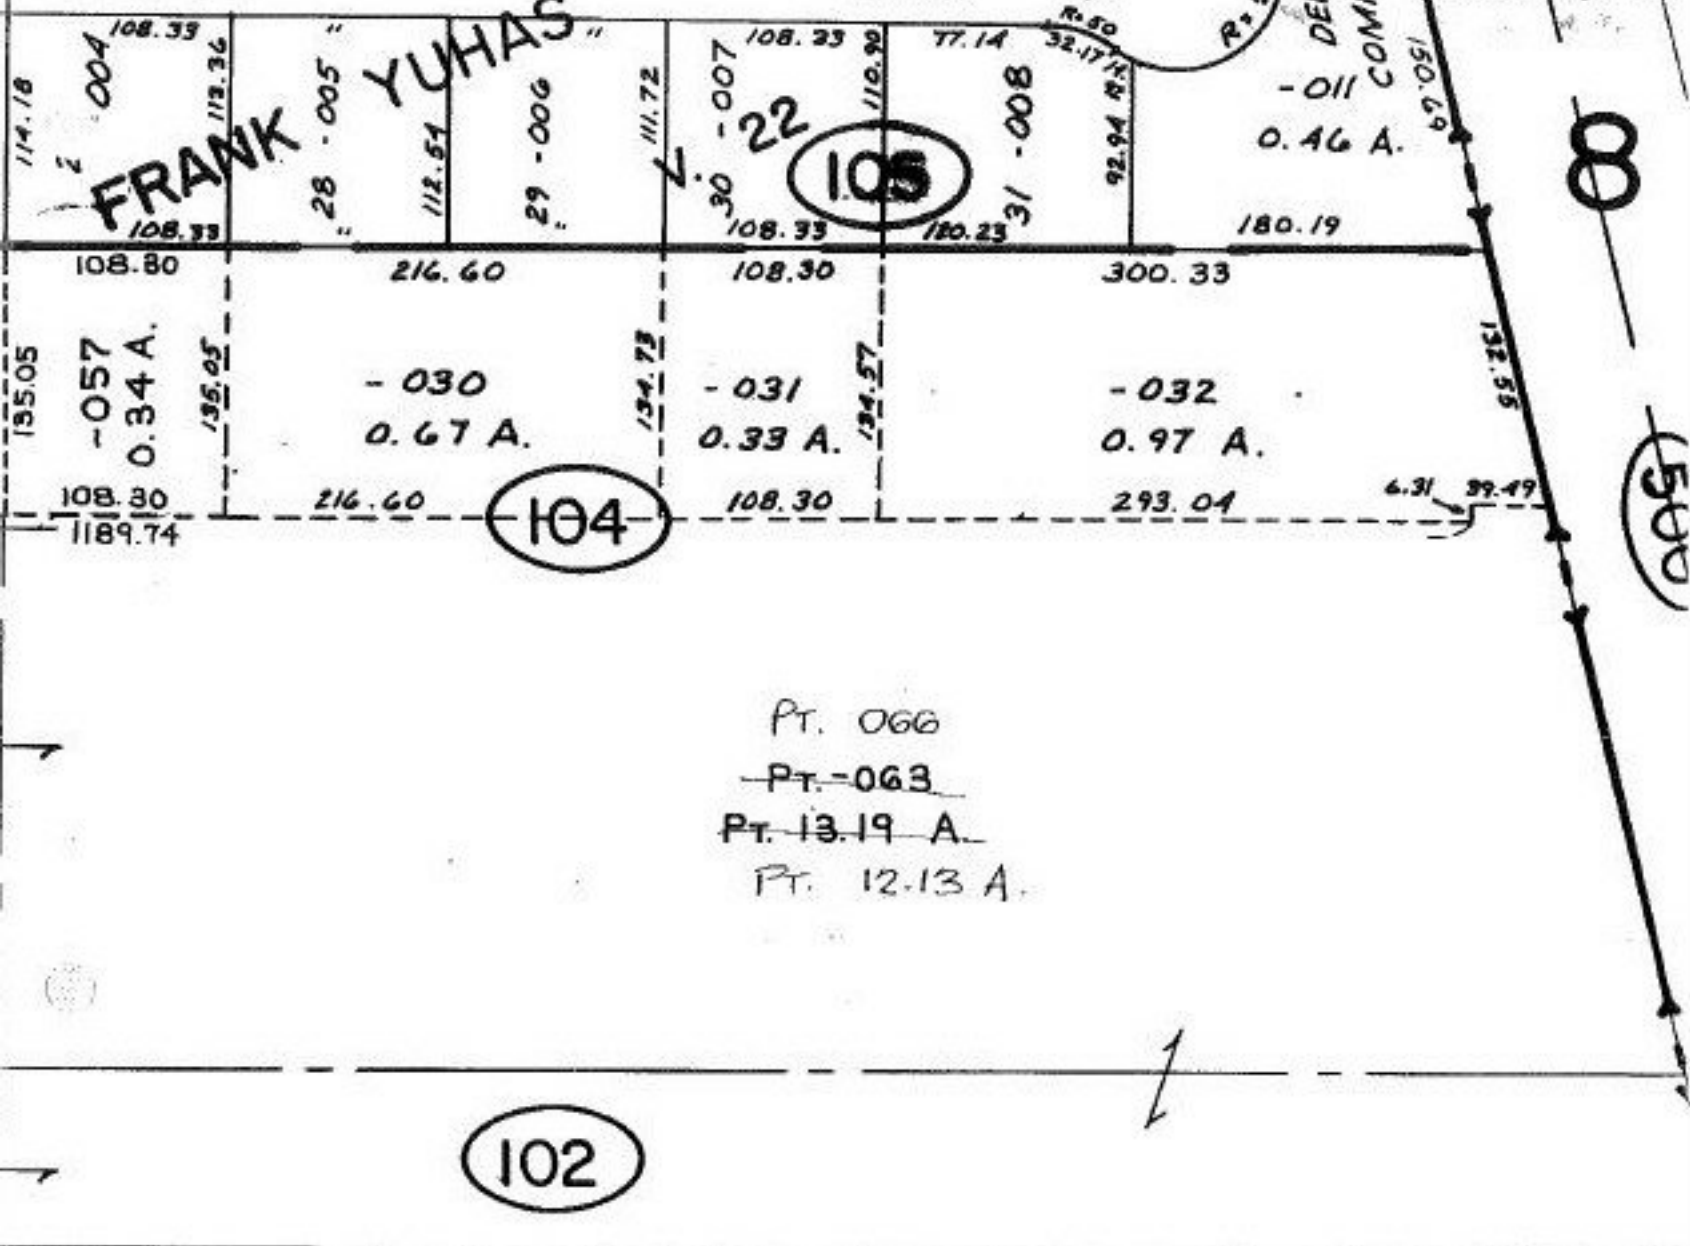


Pt. 066
~~Pt. 063~~
 Pt. 13.19 A.
 Pt. 12.13 A.

SCHADEN

SEE ENGINEERS' PLATS
BOOK 5 PG. 4

1422.75

RD.

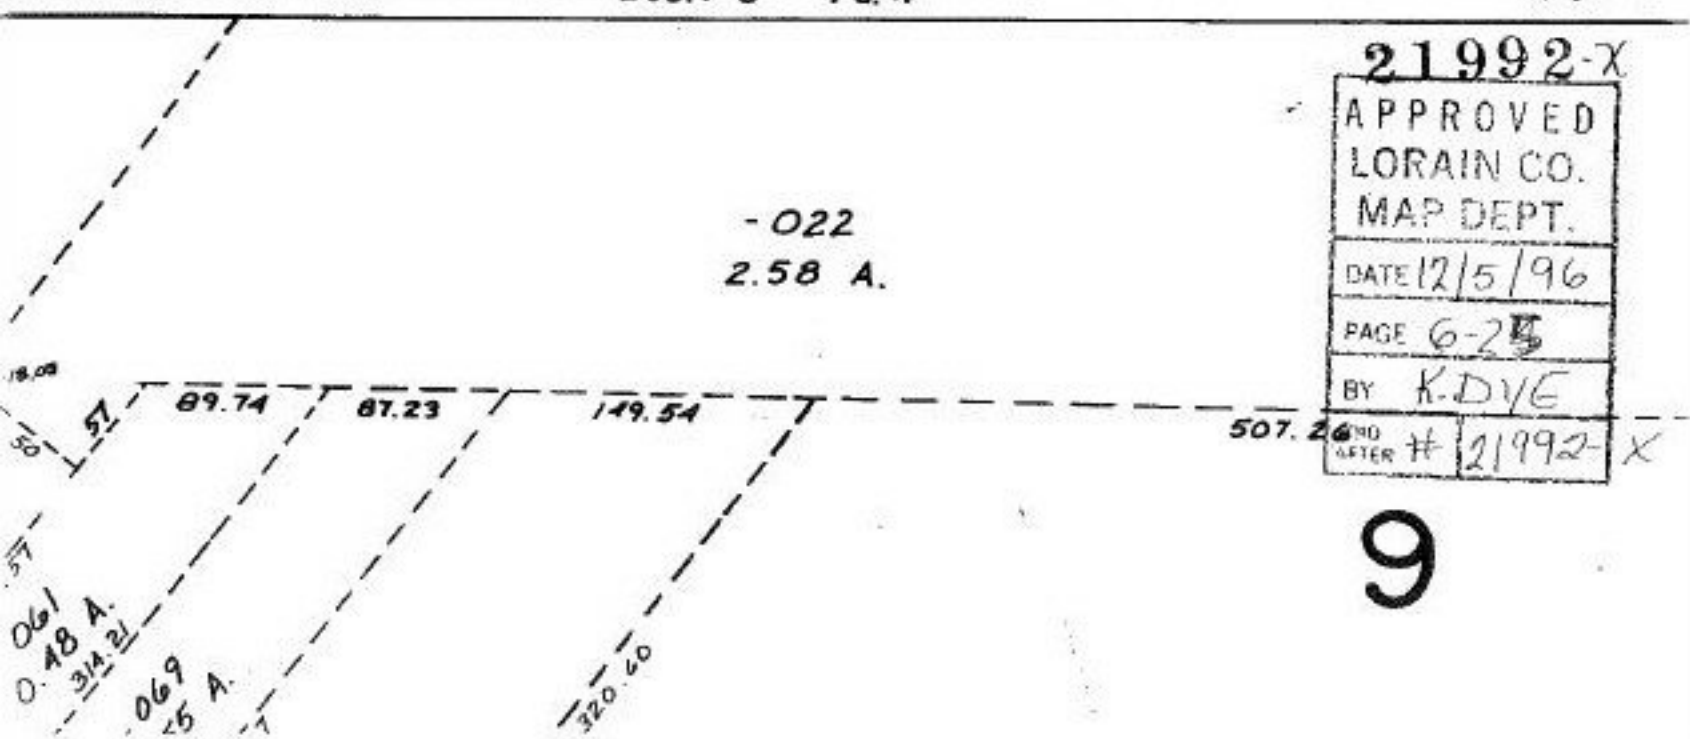

21992-X

APPROVED
LORAIN CO.
MAP DEPT.
DATE 12/5/96
PAGE 6-25
BY K.DVE
507.26 ND AFTER # 21992-X

9