


#21995-D

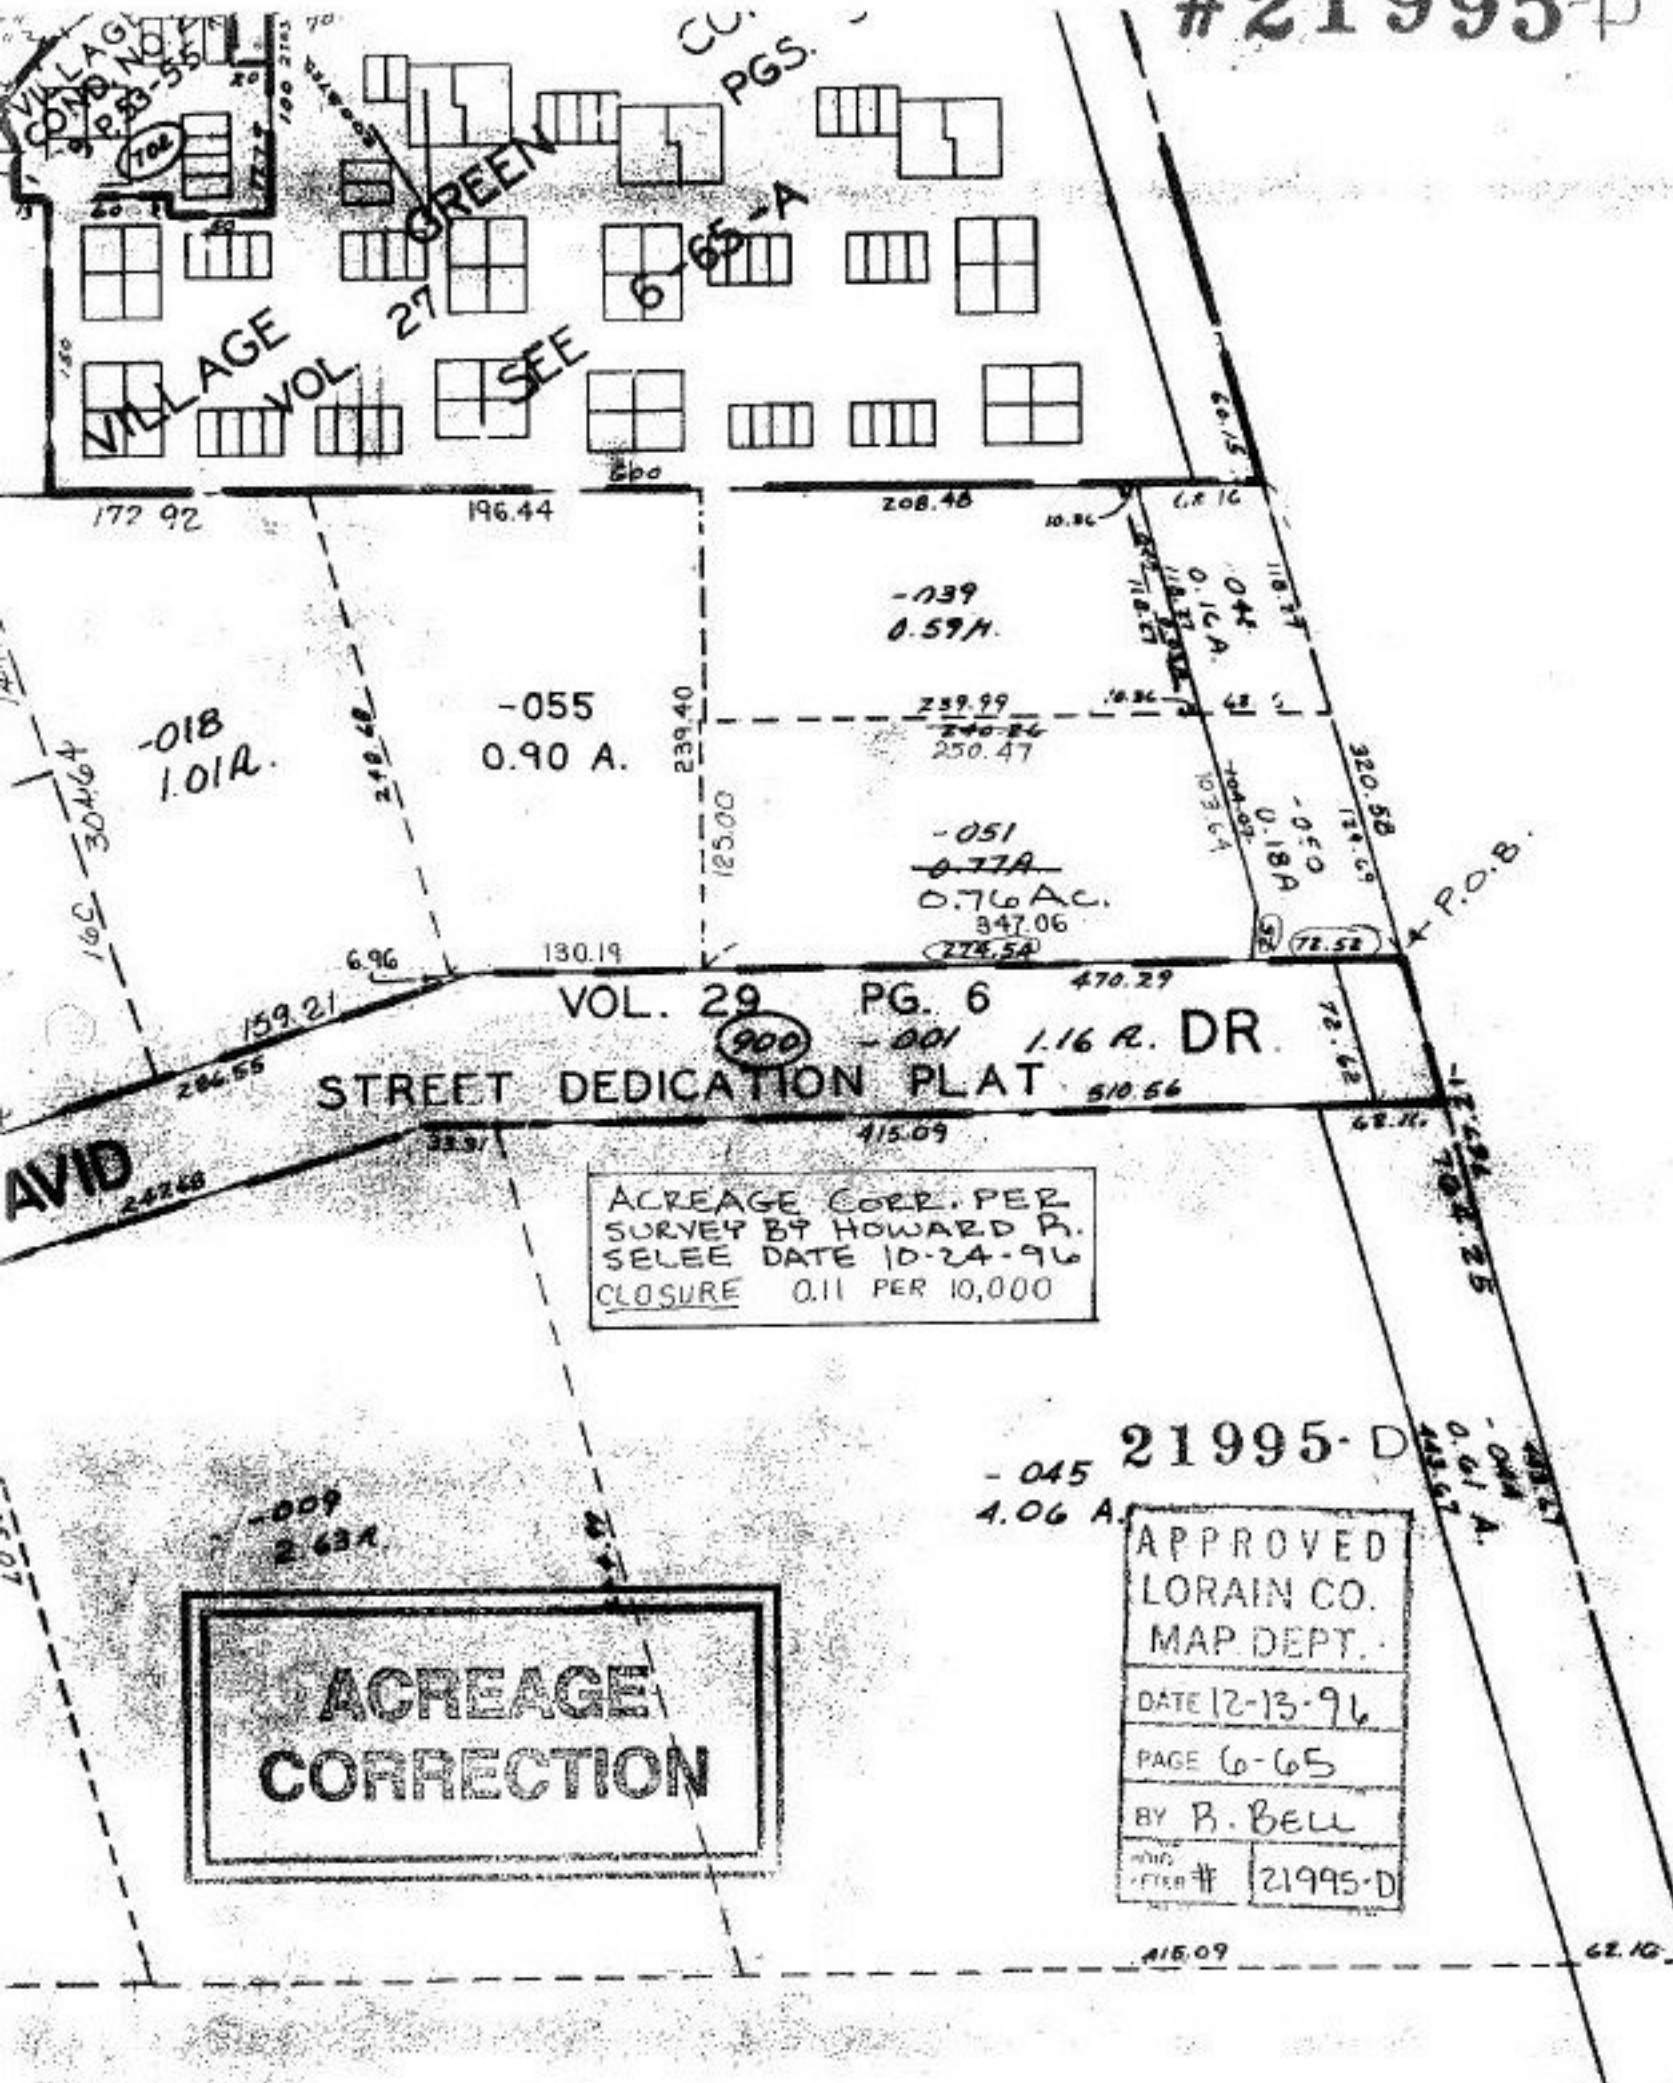

CU. PGS.

VILLAGE VOL 27 GREEN

VILLAGE VOL 27

SEE

665-A

018
1.01A.

055
0.90 A.

051
~~0.77A~~
0.76 AC.
847.06
274.54

050
0.18A

VOL. 29 PG. 6
900 - 001 1.16 R. DR.
STREET DEDICATION PLAT

ACREAGE CORR. PER SURVEY BY HOWARD P. SELEE DATE 10-24-96 CLOSURE 0.11 PER 10,000

ACREAGE CORRECTION

21995-D

045
4.06 A.

APPROVED	
LORAIN CO.	
MAP DEPT.	
DATE 12-13-96	
PAGE 6-65	
BY R. BELL	
FILE #	21995-D

009
2.63A

061 A.

415.09

62.10