


#22000-D

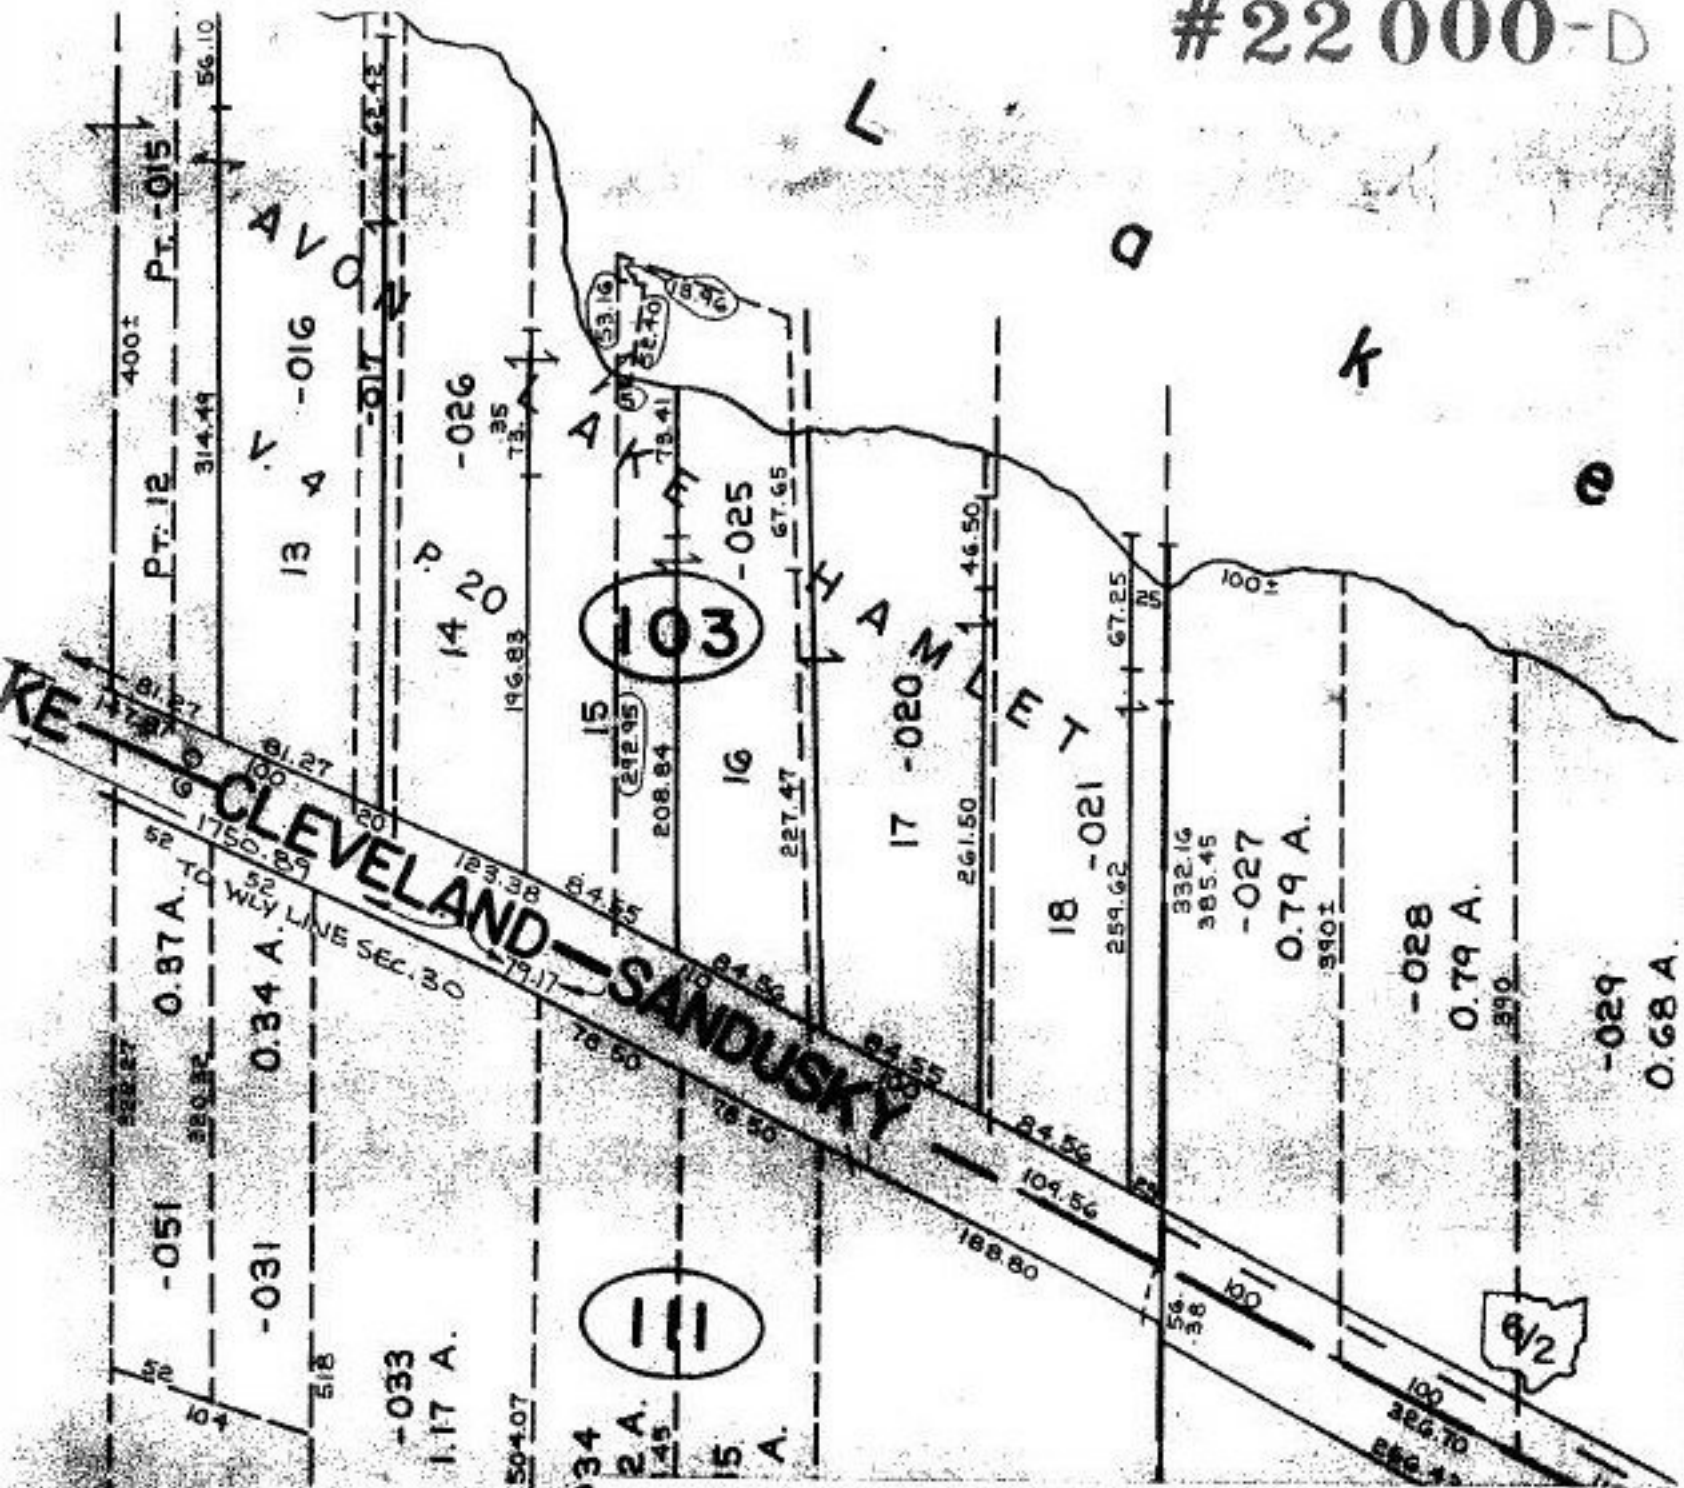

22000-D

APPROVED
 LORAIN CO.
 MAP DEPT.
 DATE 12-04-96
 PAGE 4-00-030B
 BY R. BELL
 VOID AFTER # 22000D

DEED
 CHECK

22000-D

NO CHANGES
 OF TAX MAP

