


#22002

SEE 5-D

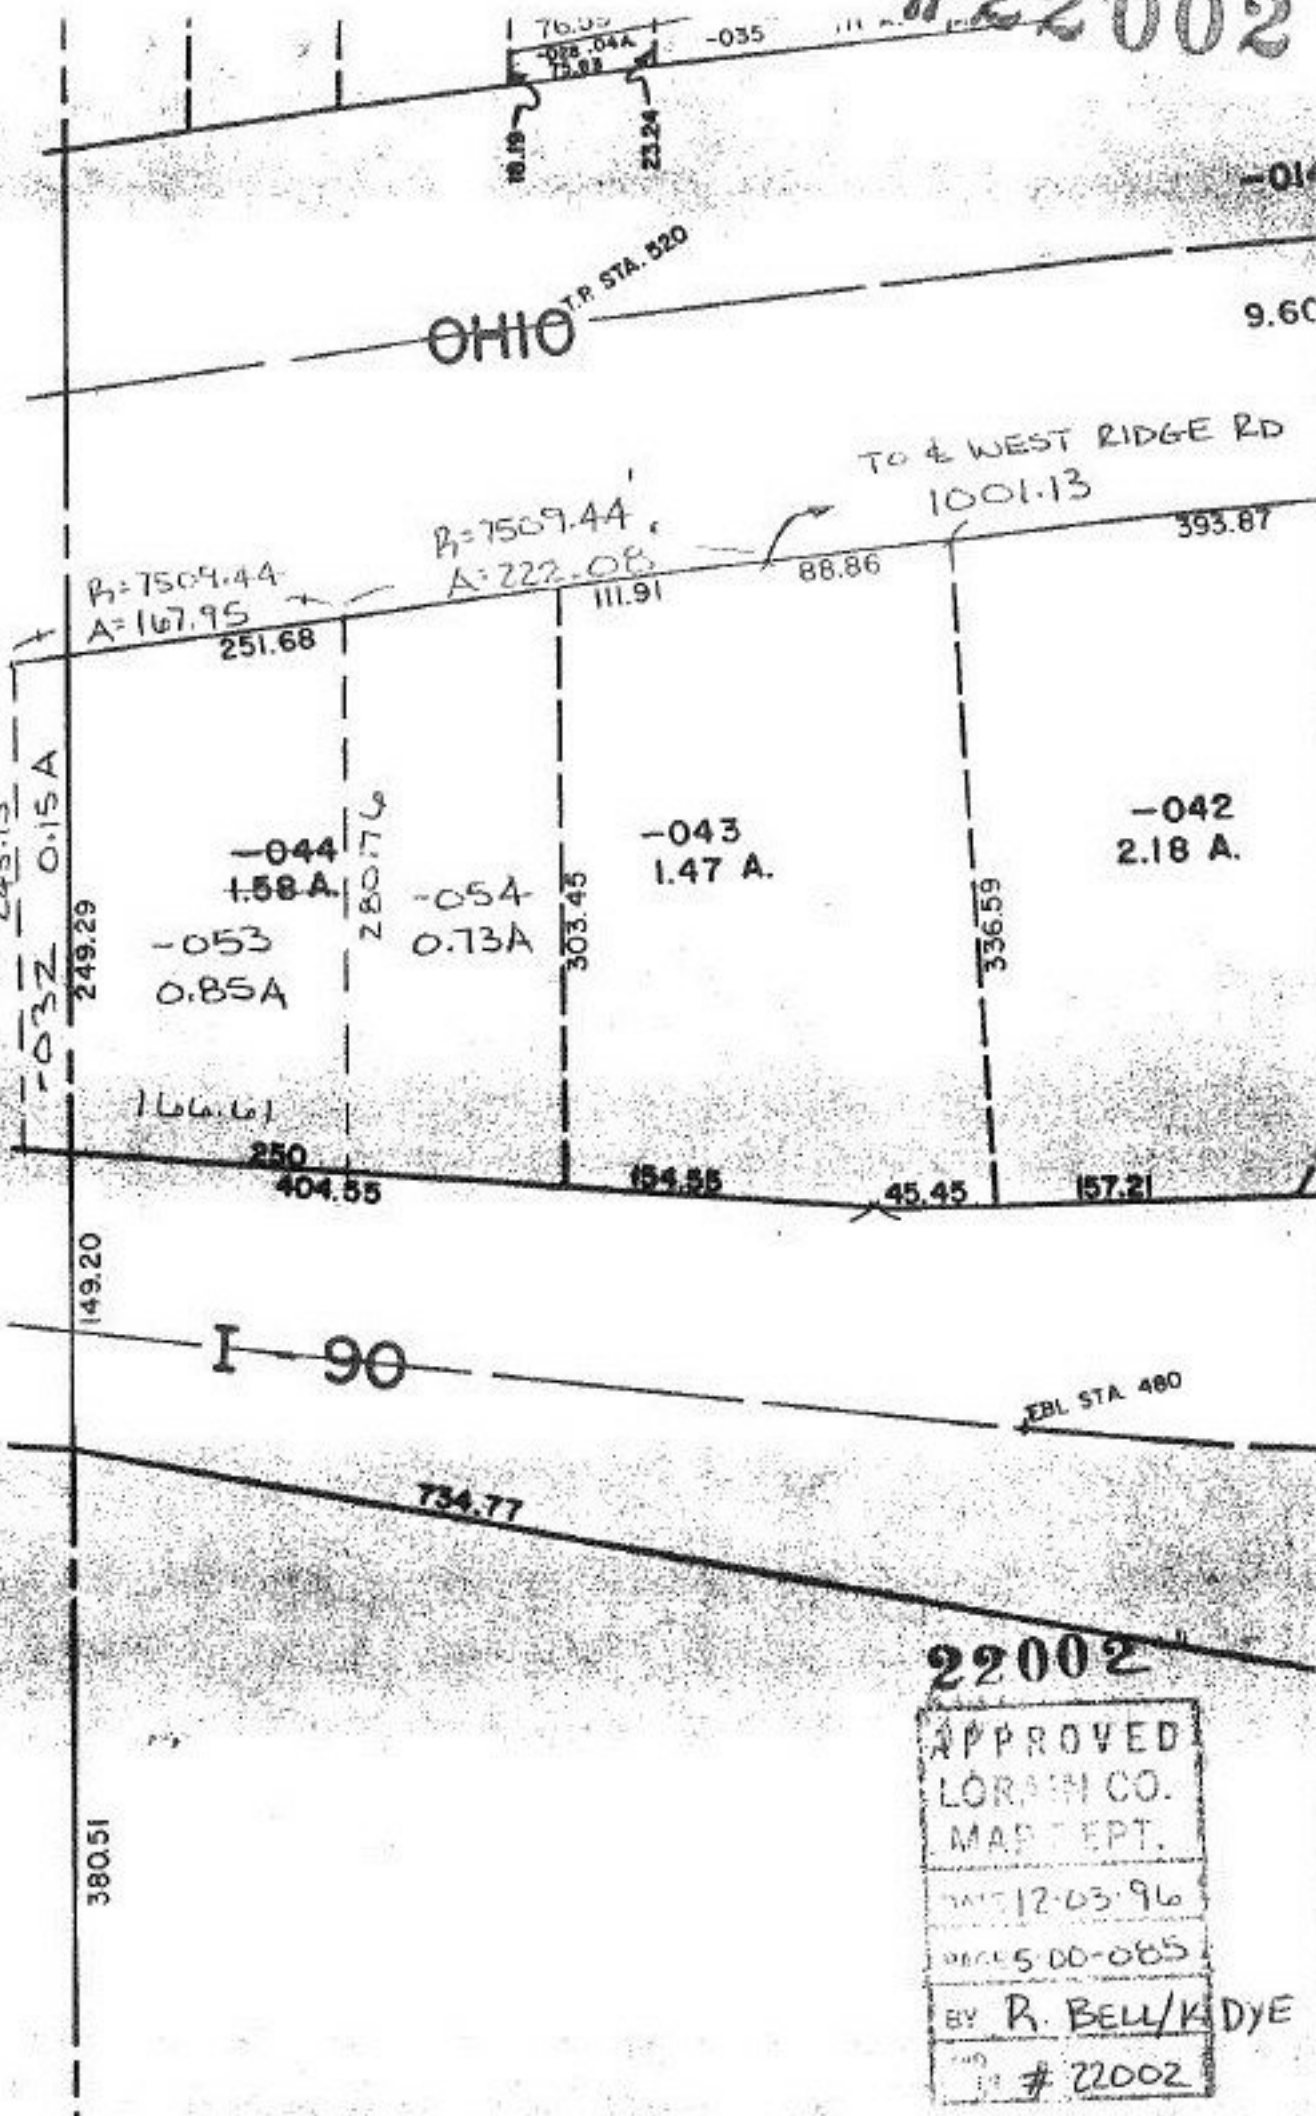

22002

APPROVED
LORAIN CO.
MAP DEPT.
DATE 12-03-96
PROJECT 00-085
BY R. BELL/K DYE
22002