


#22007
32.00 A.

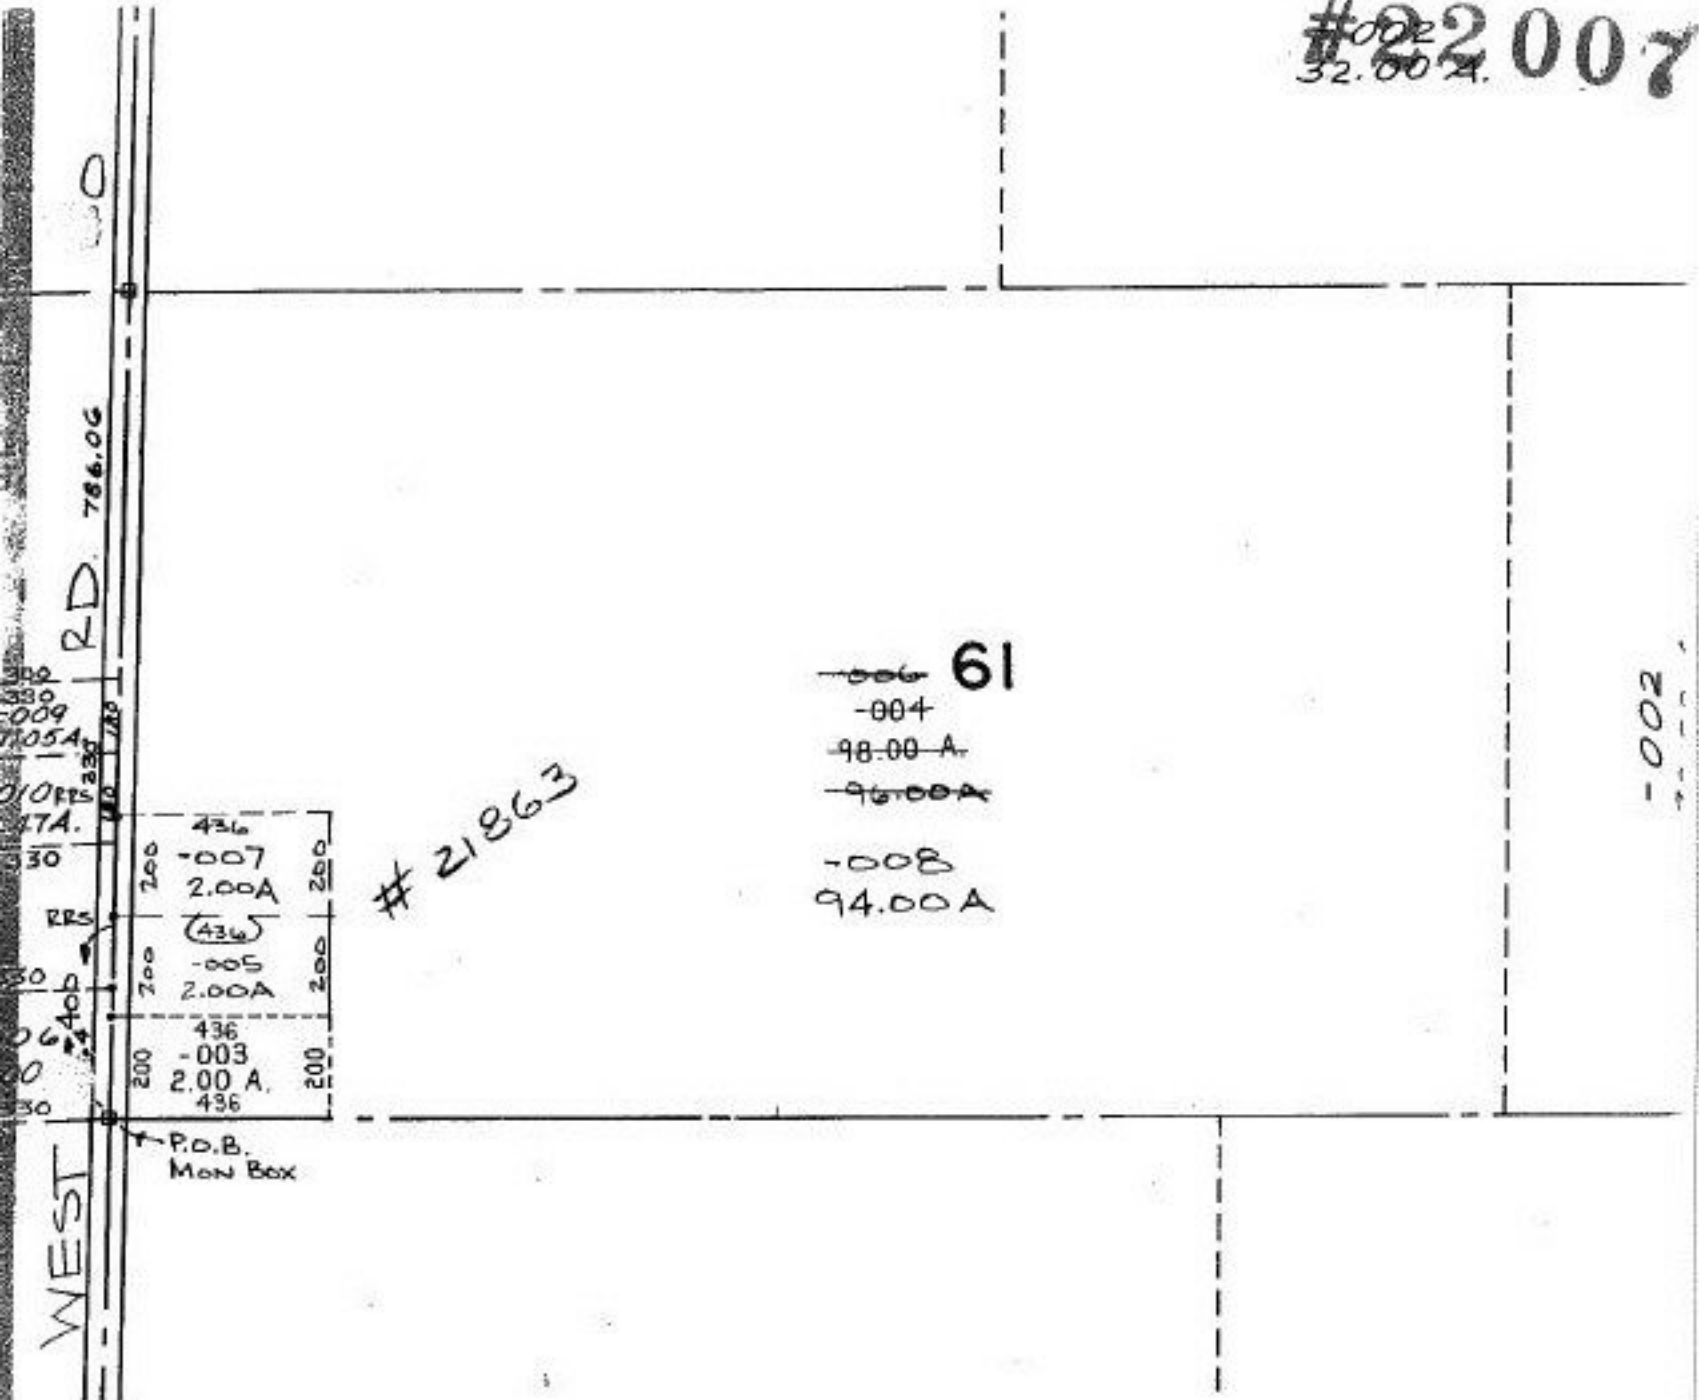

21863

~~006~~ 61
~~004~~
 98.00 A.
~~96.00 A.~~
~~008~~
 94.00 A.

-002

WEST

R.D. 766.06

200	200	436	200
200	200	-007	200
200	200	2.00A	200
200	200	(436)	200
200	200	-005	200
200	200	2.00A	200
200	200	436	200
200	200	-003	200
200	200	2.00 A.	200
200	200	436	200

P.O.B.
Man Box

22007

APPROVED	
LORAIN CO.	
MAP DEPT.	
DATE	12-09-96
PAGE	1A-D
BY	R. BELL
LAND	
OFFER #	22007