


OSBORNE

#22012

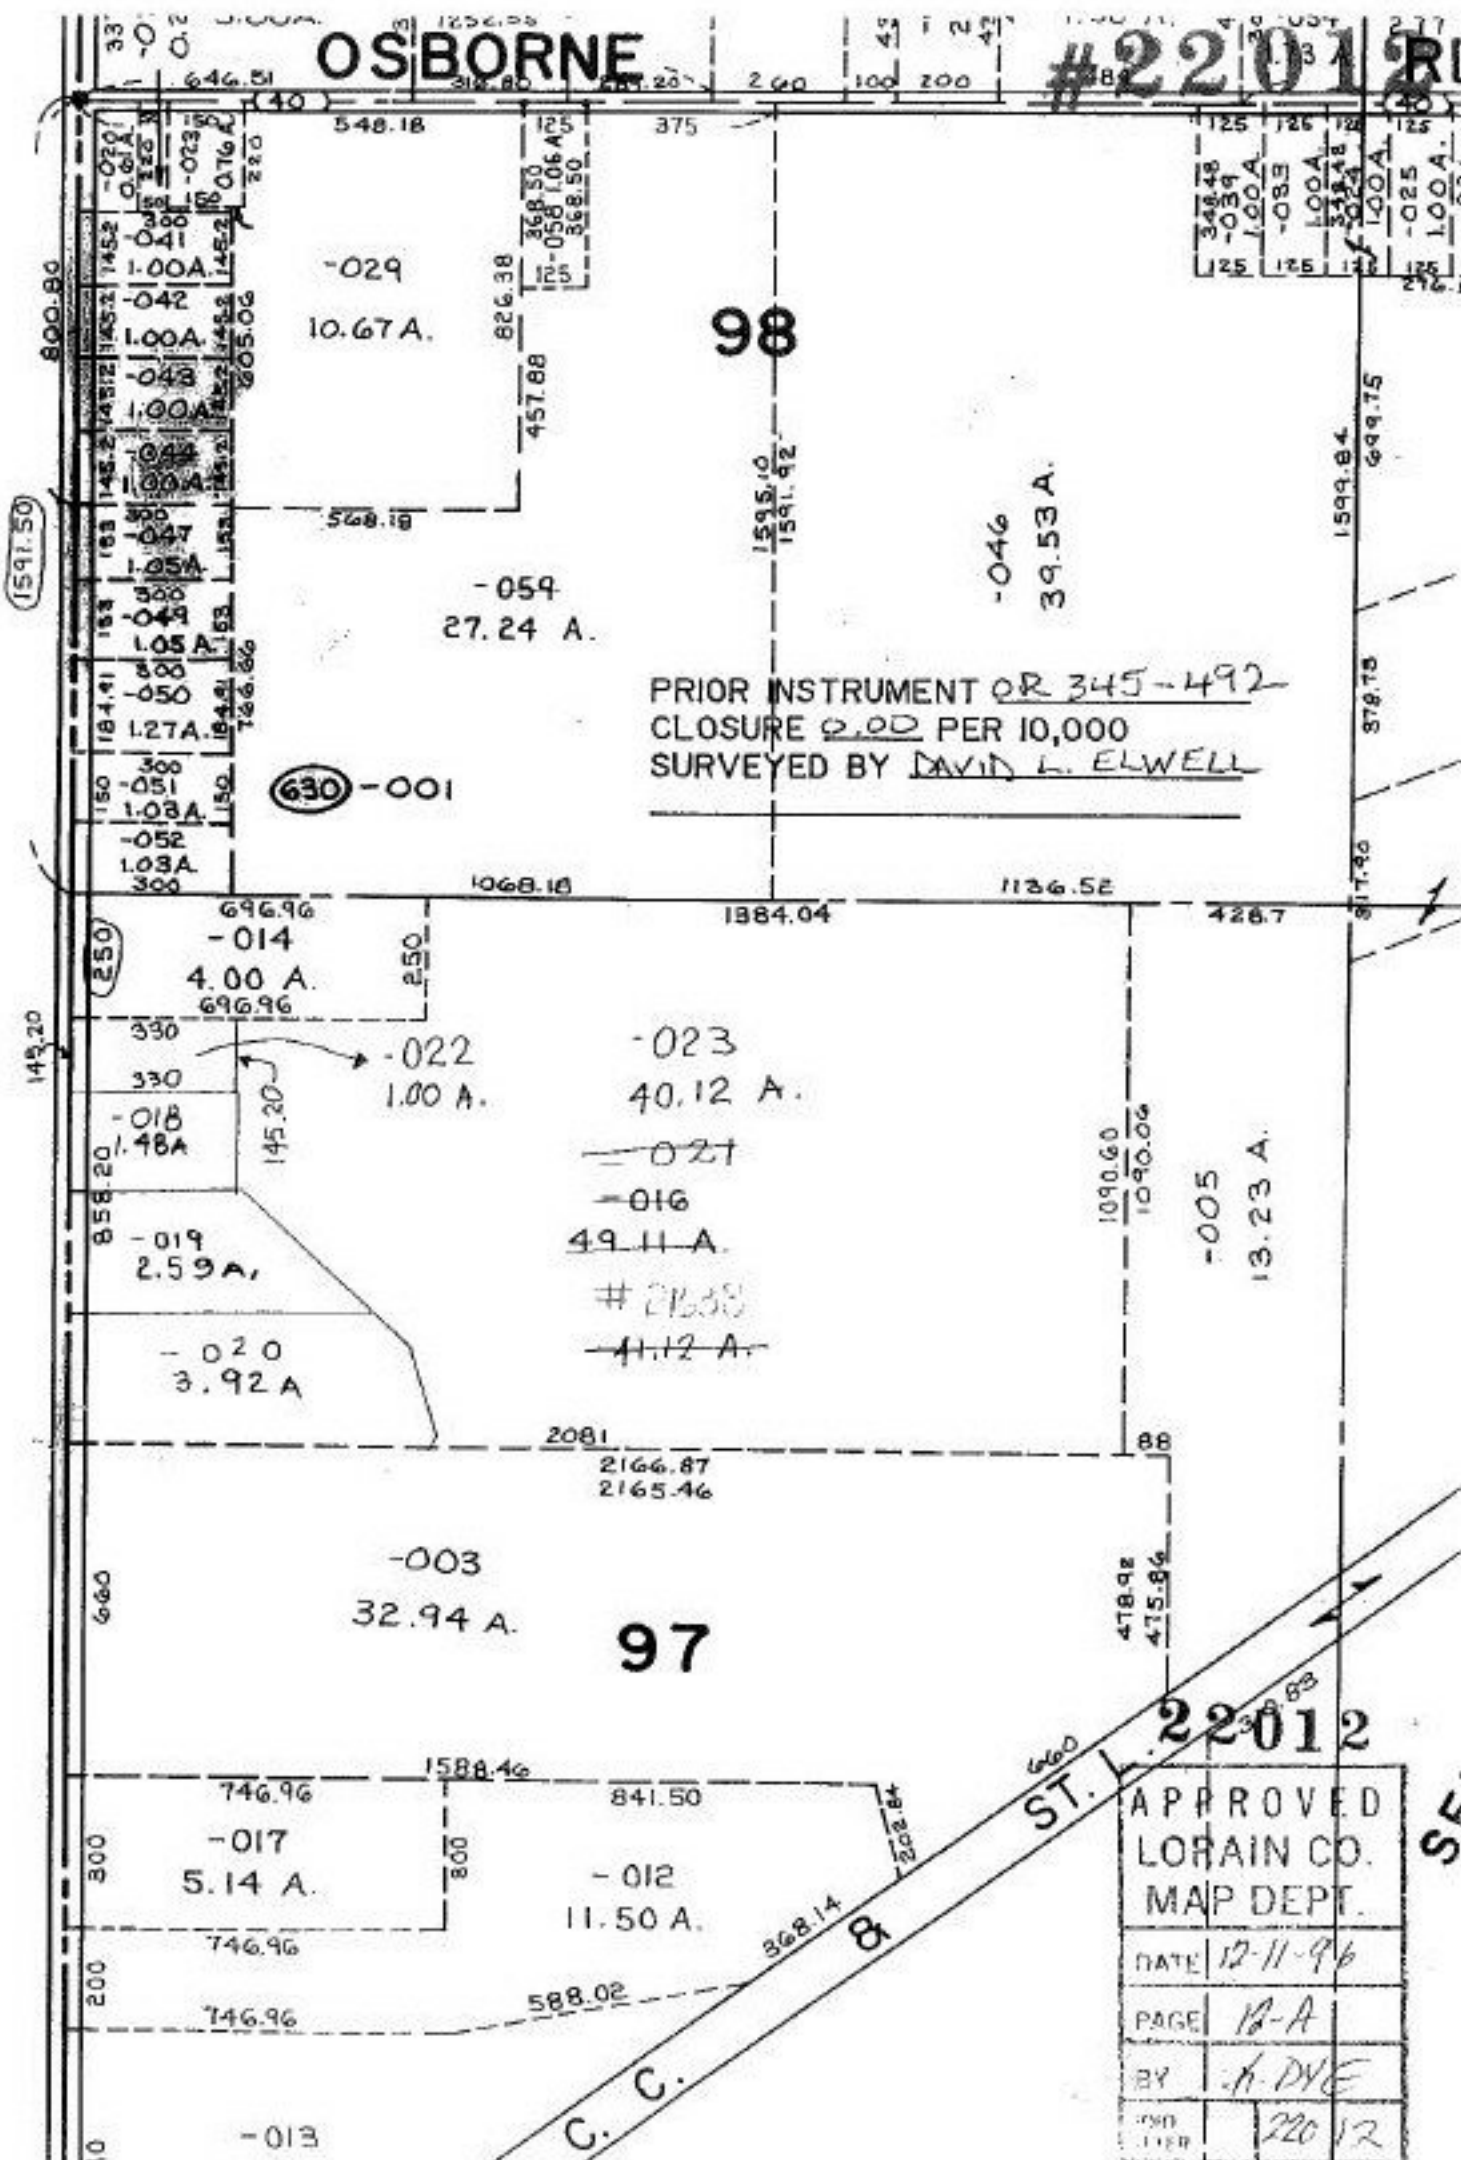

PRIOR INSTRUMENT OR 345-492
 CLOSURE 2.00 PER 10,000
 SURVEYED BY DAVID L. ELWELL

APPROVED	
LORAIN CO.	
MAP DEPT.	
DATE	12-11-96
PAGE	B-A
BY	A. DYE
NO.	22012

SE