


#22028-D

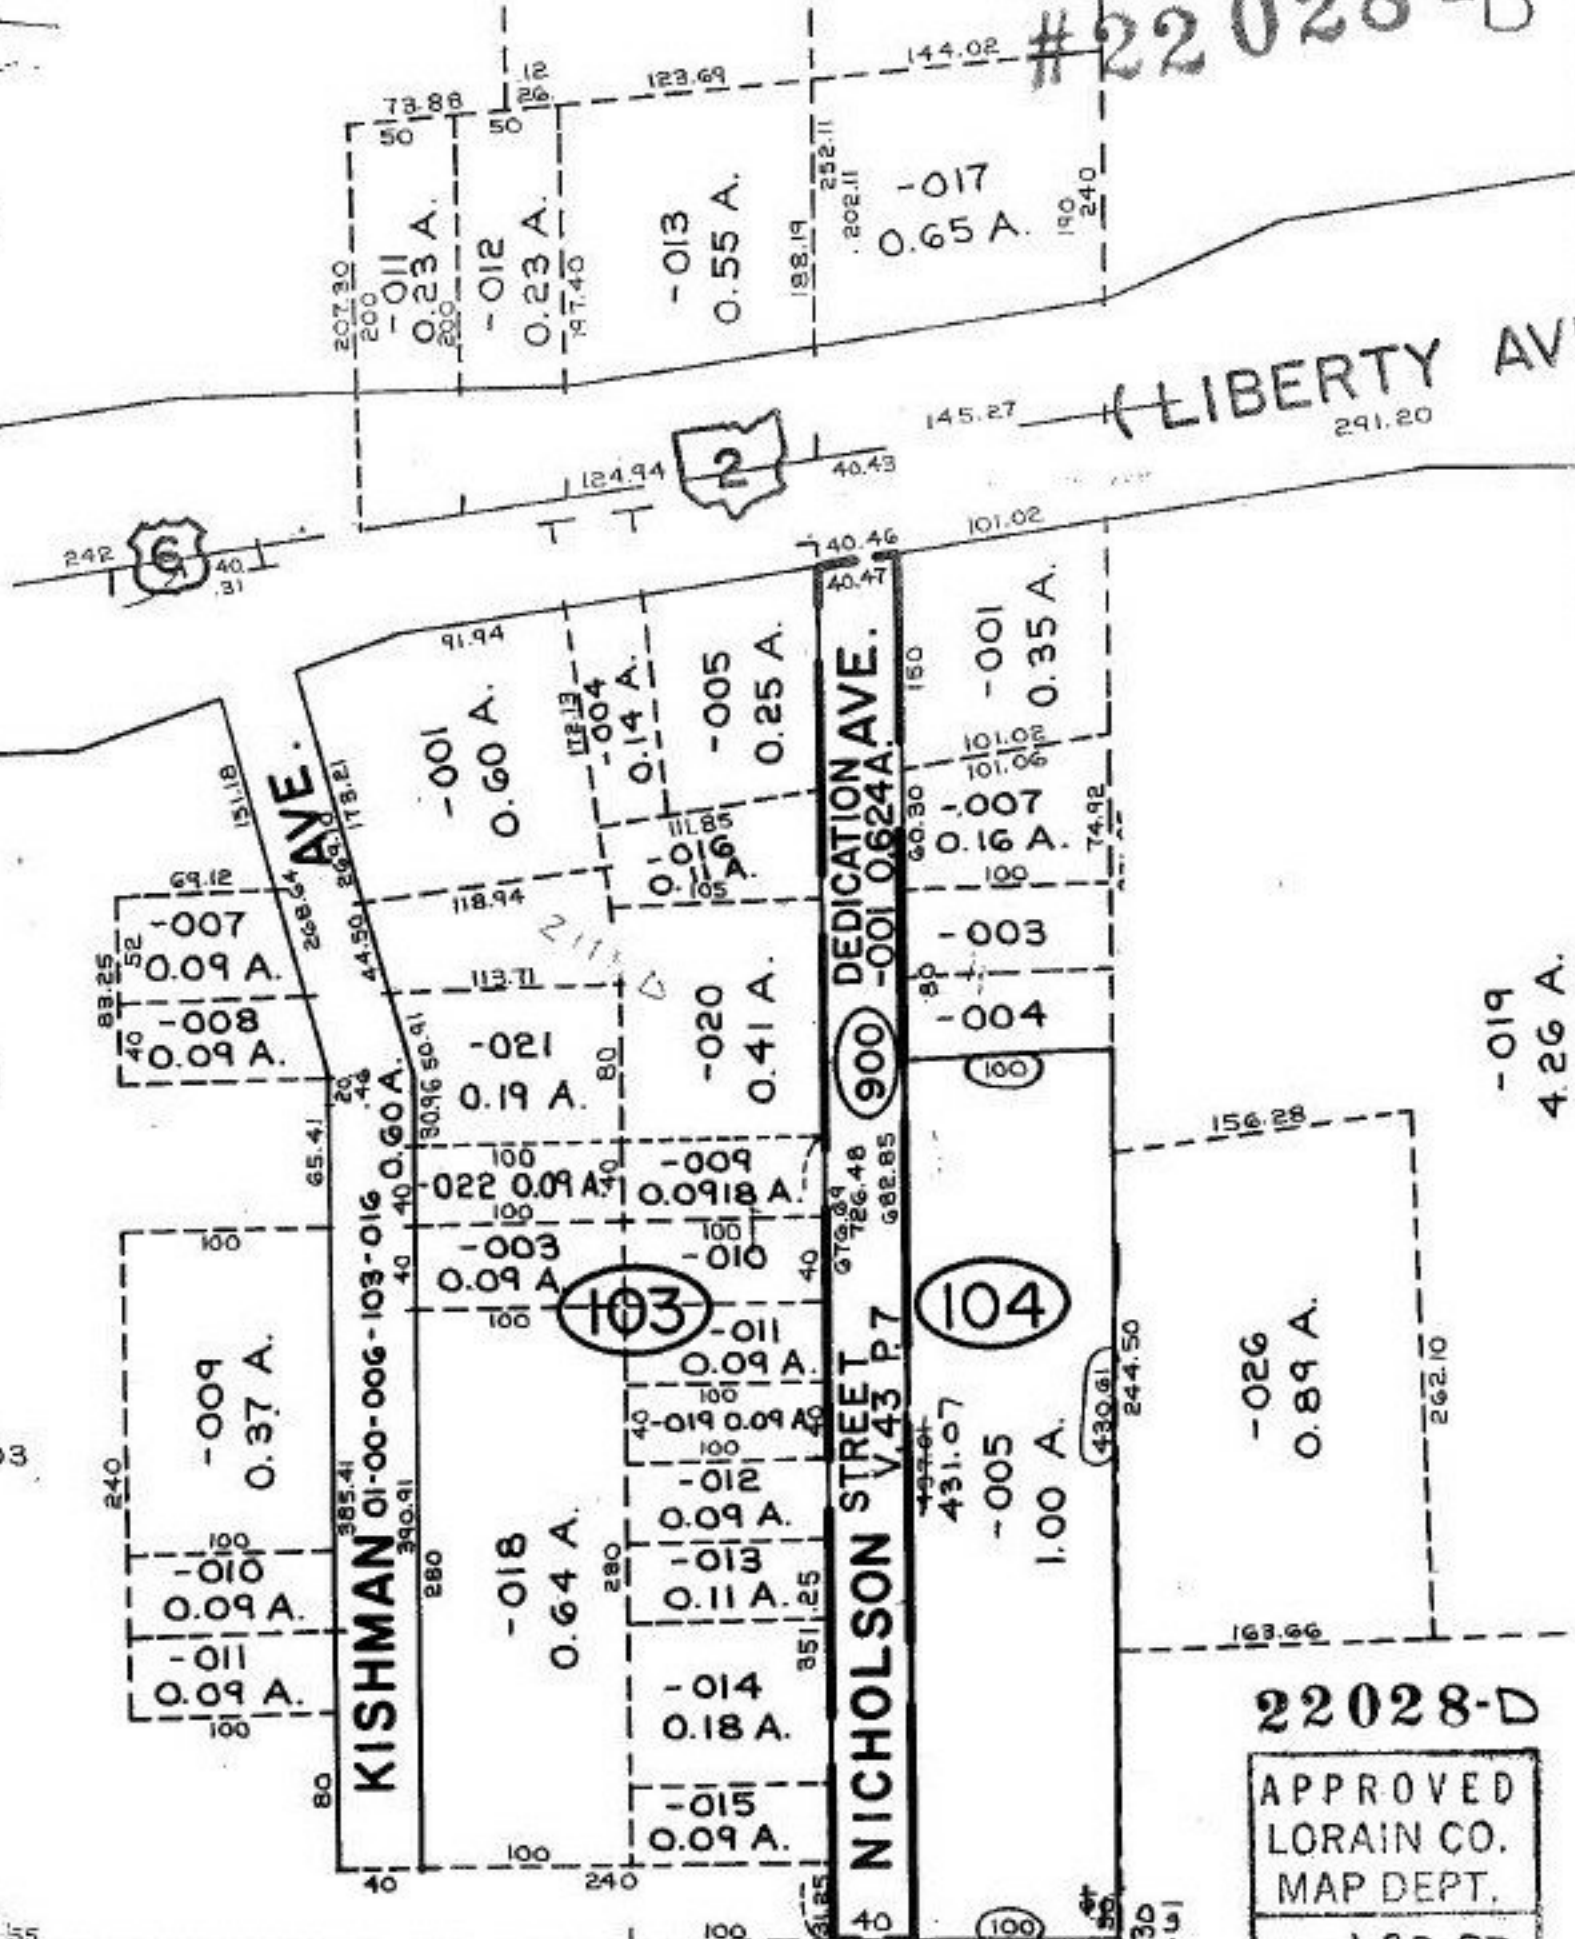

4 / 203

22028-D

APPROVED
 LORAIN CO.
 MAP DEPT.
 DATE 1-20-97
 PAGE 01-00-006 A
 BY R. BELL
 VOID AFTER #22028-D

MAP CORRECTION ONLY

1-00-006-A