


22029

JOANNE  
DV. 12/11 P. 4

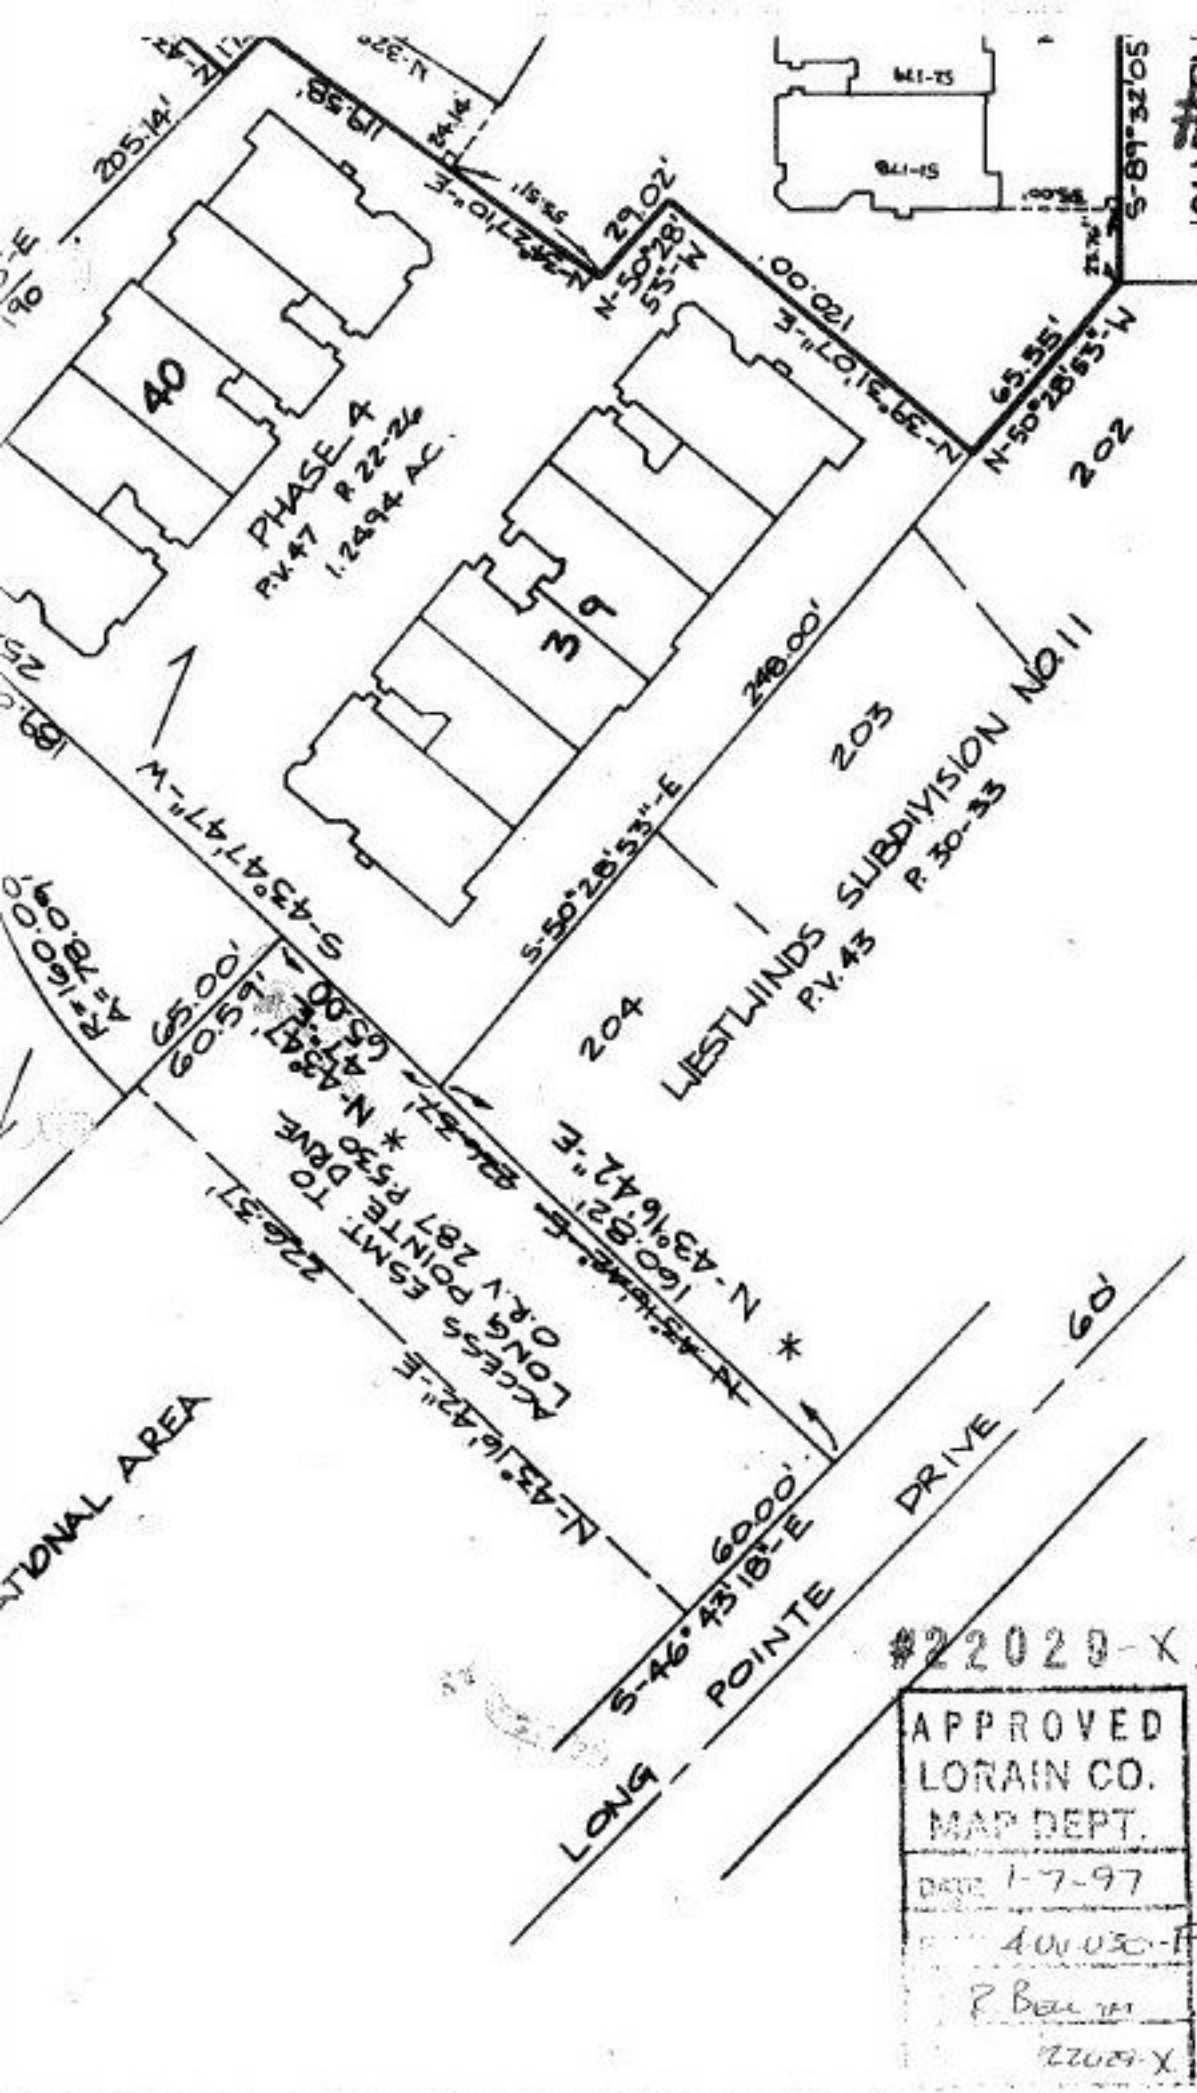

\* - CORRECTIONS PER CERTIFICATE OF  
 CORRECTION RECORDED IN O.P.N. 1726  
 P. 706.

#22029-X

APPROVED  
 LORAIN CO.  
 MAP DEPT.  
 DATE 1-7-97  
 400.030-17  
 P. Bell 101  
 22029-X

PLAT VI 49 PG 14-22  
 W 50 PG 24-33  
 VI 52 PG 1-6  
 VI 52 PG 78-84  
 VI 54 PG 8-12  
 VI 54 PG 63-66