


FILE

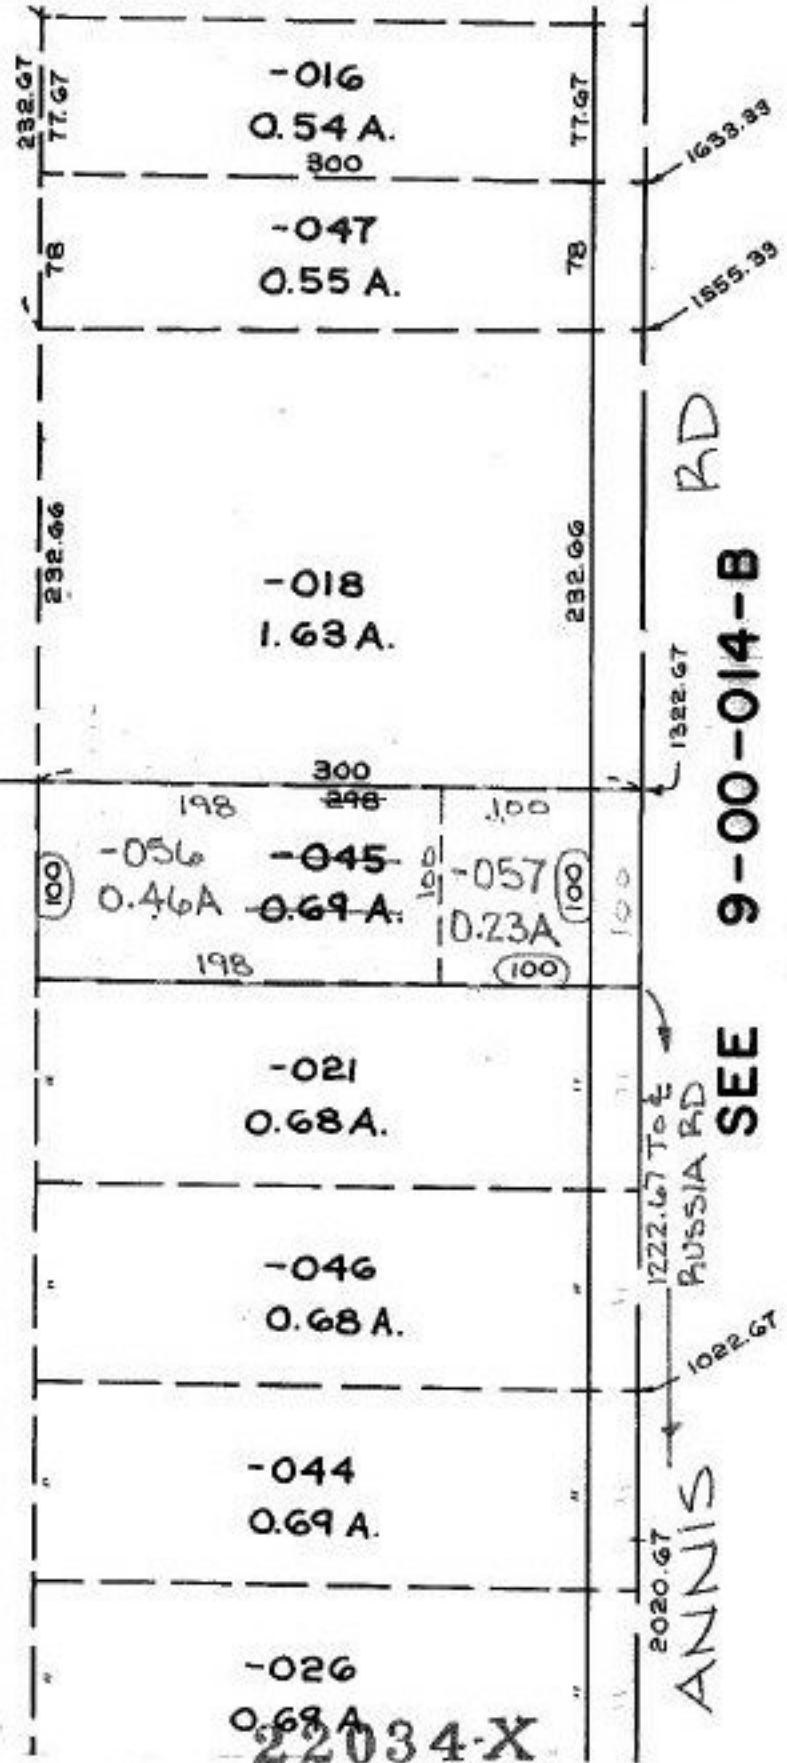

SEE 9-00-014-B

UNCOMBINATION

PARCEL UNCOMBINED PER DESC. IN. OR 1403 P. 298

EFFECTIVE 9/30/97

APPROVED
 LORAIN CO.
 MAP DEPT.
 DATE 1-07-97
 PAGE 9-00-014A
 BY P. BELL
 WORD AFTER # 22034-X

TS
11-3-97