

#22034

883.54

(141)

884.30
788.26

- 170
21.62 A. (1)

- 143
36.50 A.

1065.78

22034

APPROVED	
LORAIN CO.	
MAP DEPT.	
DATE 12-31-96	
PAGE 4-00-030 E	
BY	<i>[Signature]</i>
VOID AFTER	22034


- 171
~~14.88 A.~~
14.92 A. (2)
PER SURVEY
DONALD E. WOIKE

312.63

99.19

207.83

1104

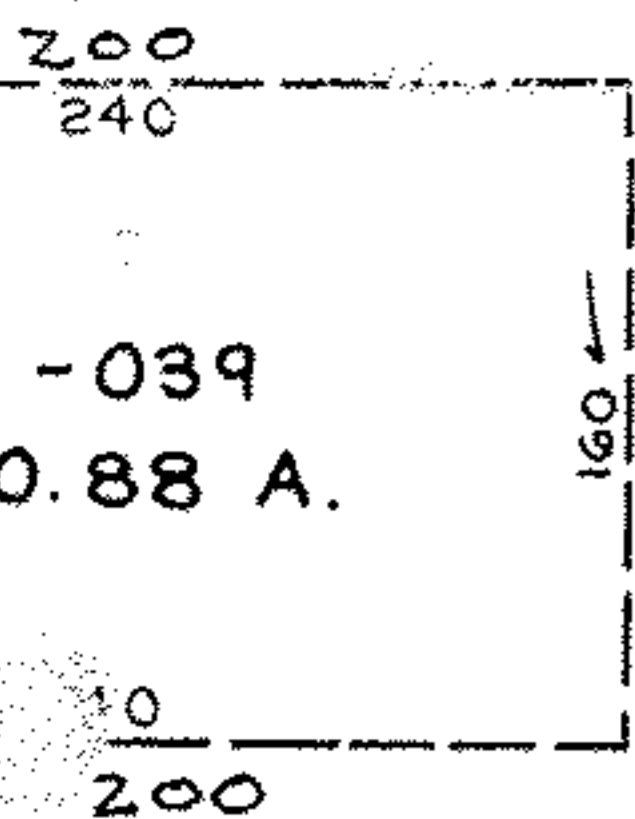

428.50
481.50

- 041
7.05 A.

637.31
637.31

481.50

456.22

- 009
1.07 A.

475.22