
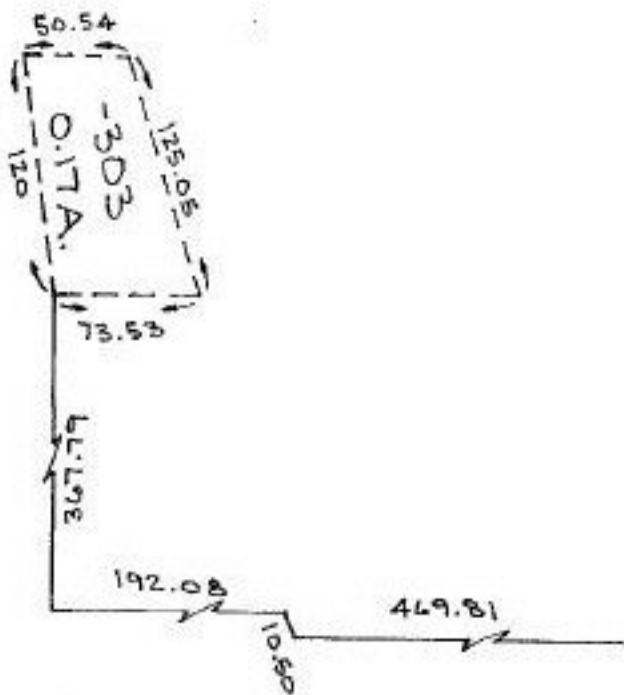


#22040

#3 -001
28.93 A. ✓
VILLAGES

SEE 11-00-099-B

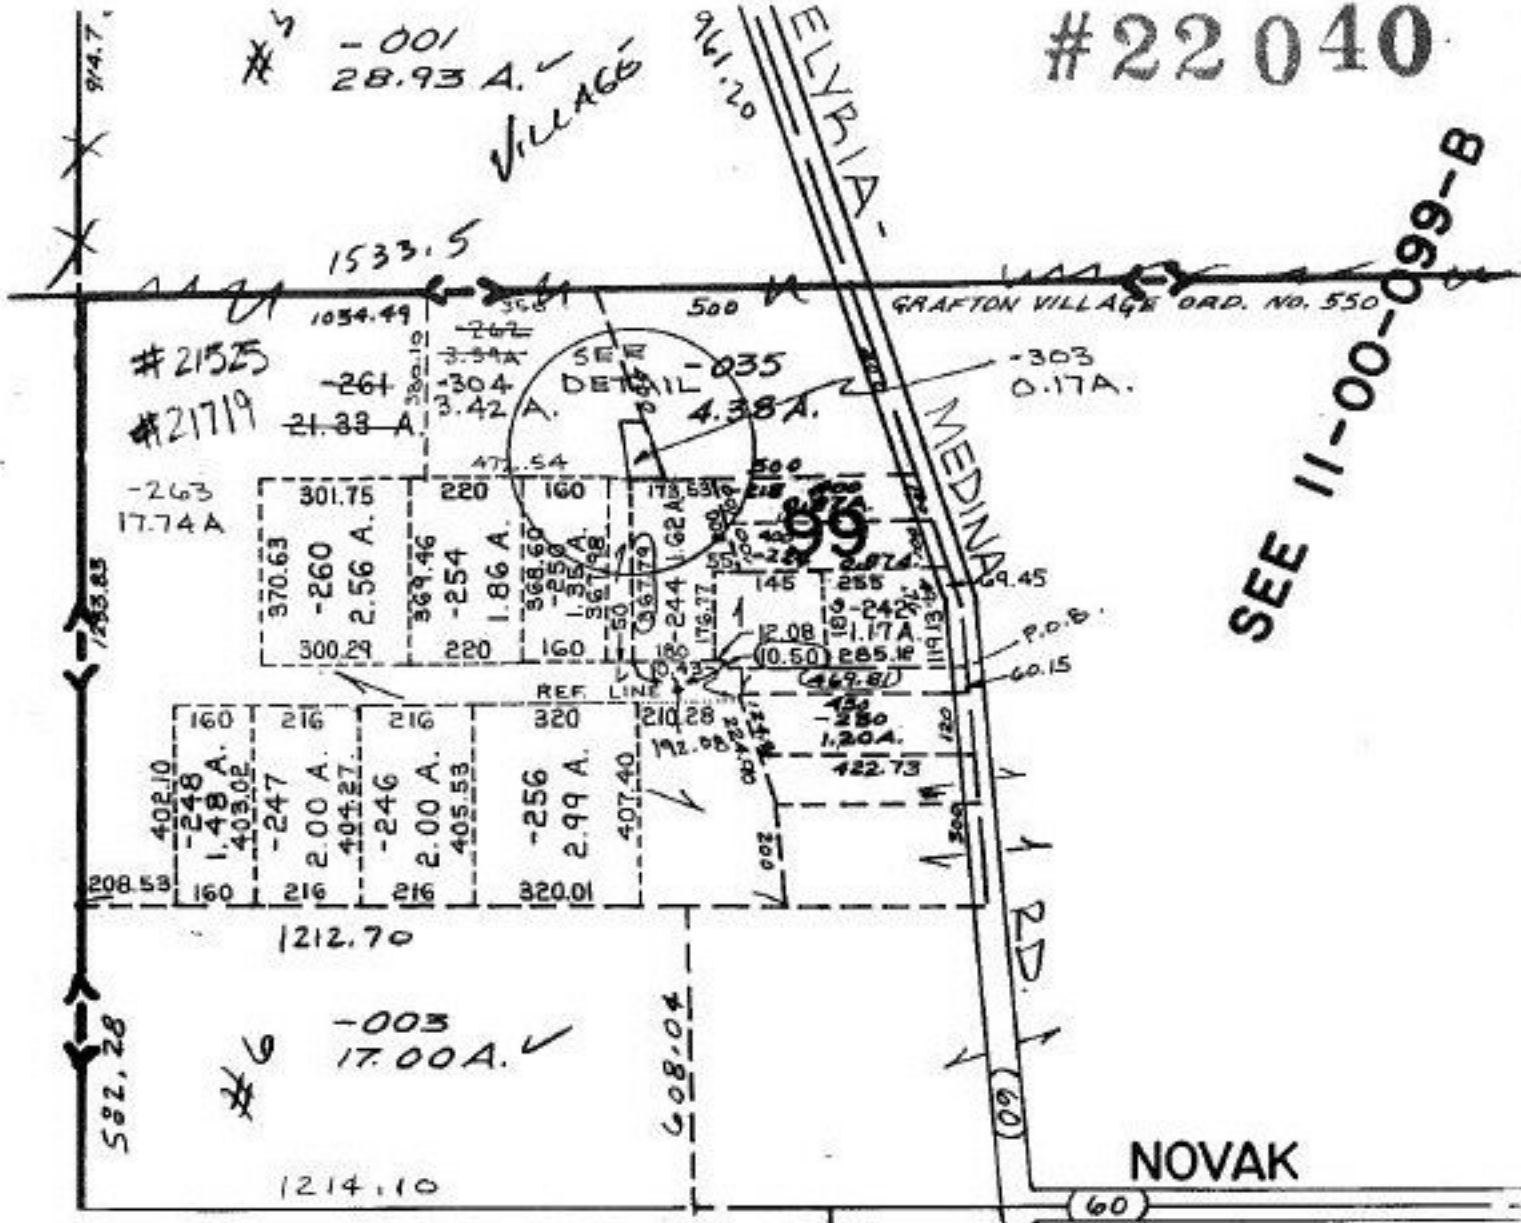

DETAIL
1" = 100'

22040

APPROVED
LORAIN CO.
MAP DEPT.
DATE 1-16-97
PAGE 11-E SOUTH
BY R. BELL
VOID AFTER # 22040