


61  
-138

62  
-139

CORRECTED ON PLAT V. 55/28  
STILL NEEDS TO BE CORRECTED  
ON MYLAR 4.00.019.F  
11-14-97

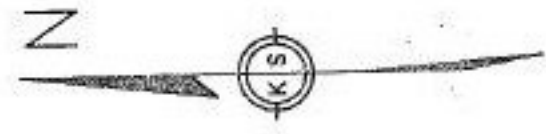

AREA IN 1 SUBLOT  
AREA IN RIGHT-OF-WAY  
TOTAL AREA IN SUBDIVISION

\* - CORRECTIONS PER CERTIFICATE  
OF CORRECTION RECORDED IN  
O.R.V. 1141 P. 625

AVON  
LAKE

GRAPHIC SCALE



( IN FEET )  
1 inch = 40 ft  
ADDED CERTIFICATE OF  
CORRECTIONS TO PLAT

#22042-X

APPROVED
LORAIN CO.
MAP DEPT.
DATE 01-27-97
P.V. 55
PAGE P. 25
BY R. Bell
VOID AFTER

4-00-019.F

DATE: 5-31-95
DRAWN BY: JEC/MJC/DB
CH'D BY: PAR
F.B. 152 & 179
DWG. NAME: 92315-2A PLAT

REVISIONS

5-21