


# CEMETERY

VILLAGE  
TWP.

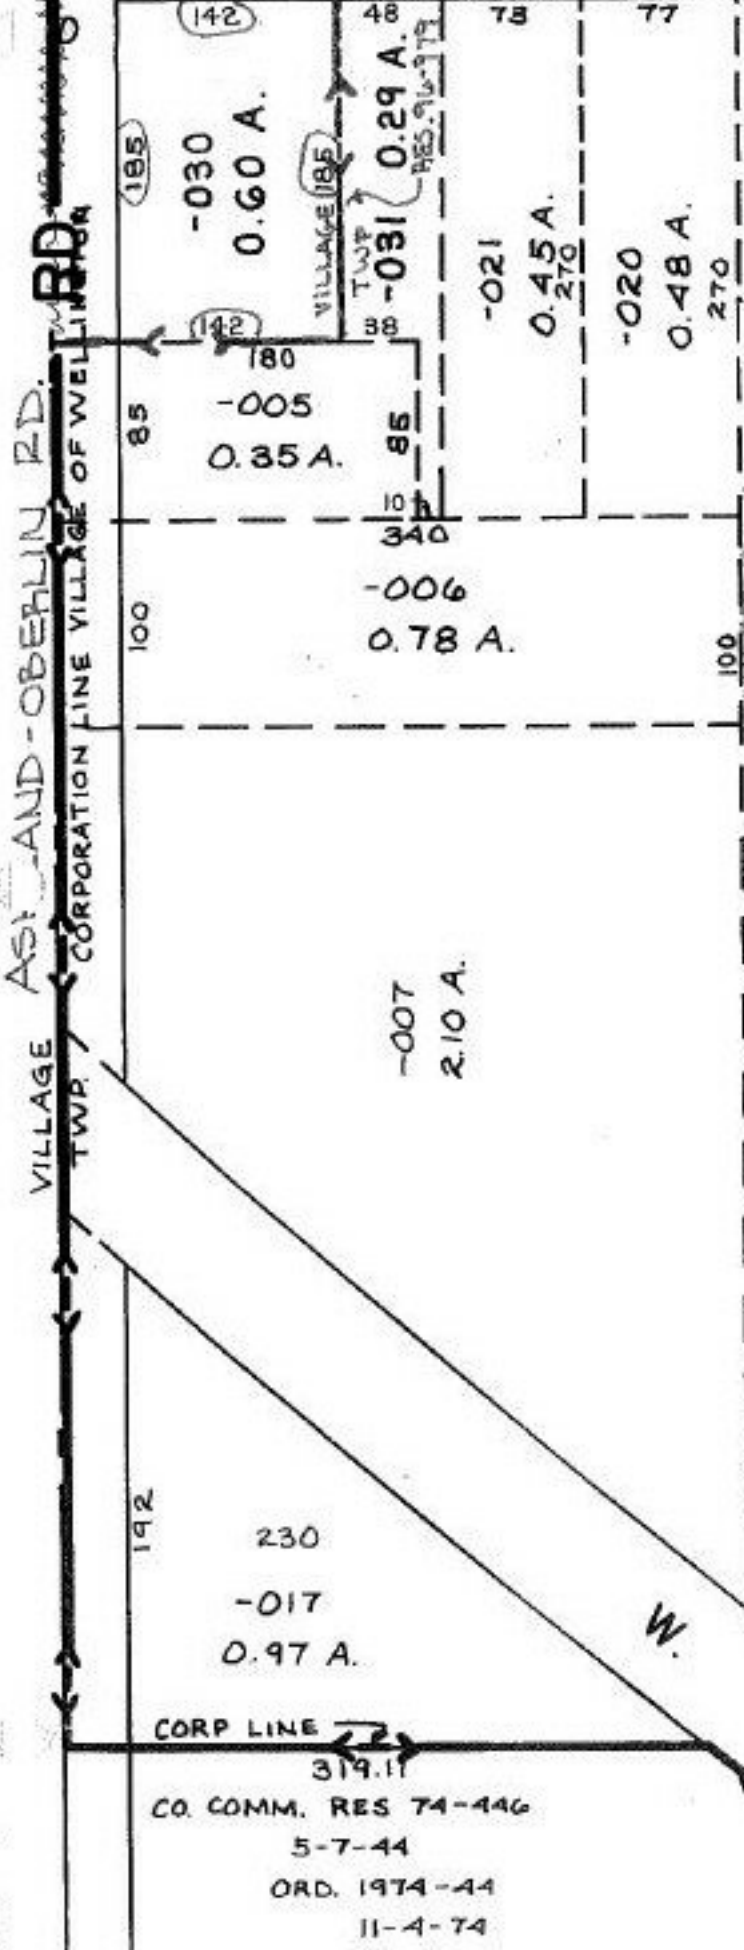

KAREN WEBB VILLAGE CLERK

647-AC26

SHE CALLED BACK TO SAY  
 VILLAGE IS DOING BATTLE W/ TWP.  
 & WILL NOT PASS ACCEPTANCE ORD.  
 AT THIS TIME. THEY WILL KEEP  
 US INFORMED OF ANY NEW  
 PAPERWORK THAT THEY

2-3-2000  
PROCESS THIS

*Frank Lohbeck*

## 22043-X

TS  
3-15-00

APPROVED LORAIN CO. MAP DEPT.	
DATE 2-10-97	
PAGE 18-00-023A	
BY R. BELL	
VOID AFTER #	22043-X

CORP LINE  
 319.11  
 CO. COMM. RES 74-446  
 5-7-44  
 ORD. 1974-44  
 11-4-74

44-C