


#22045

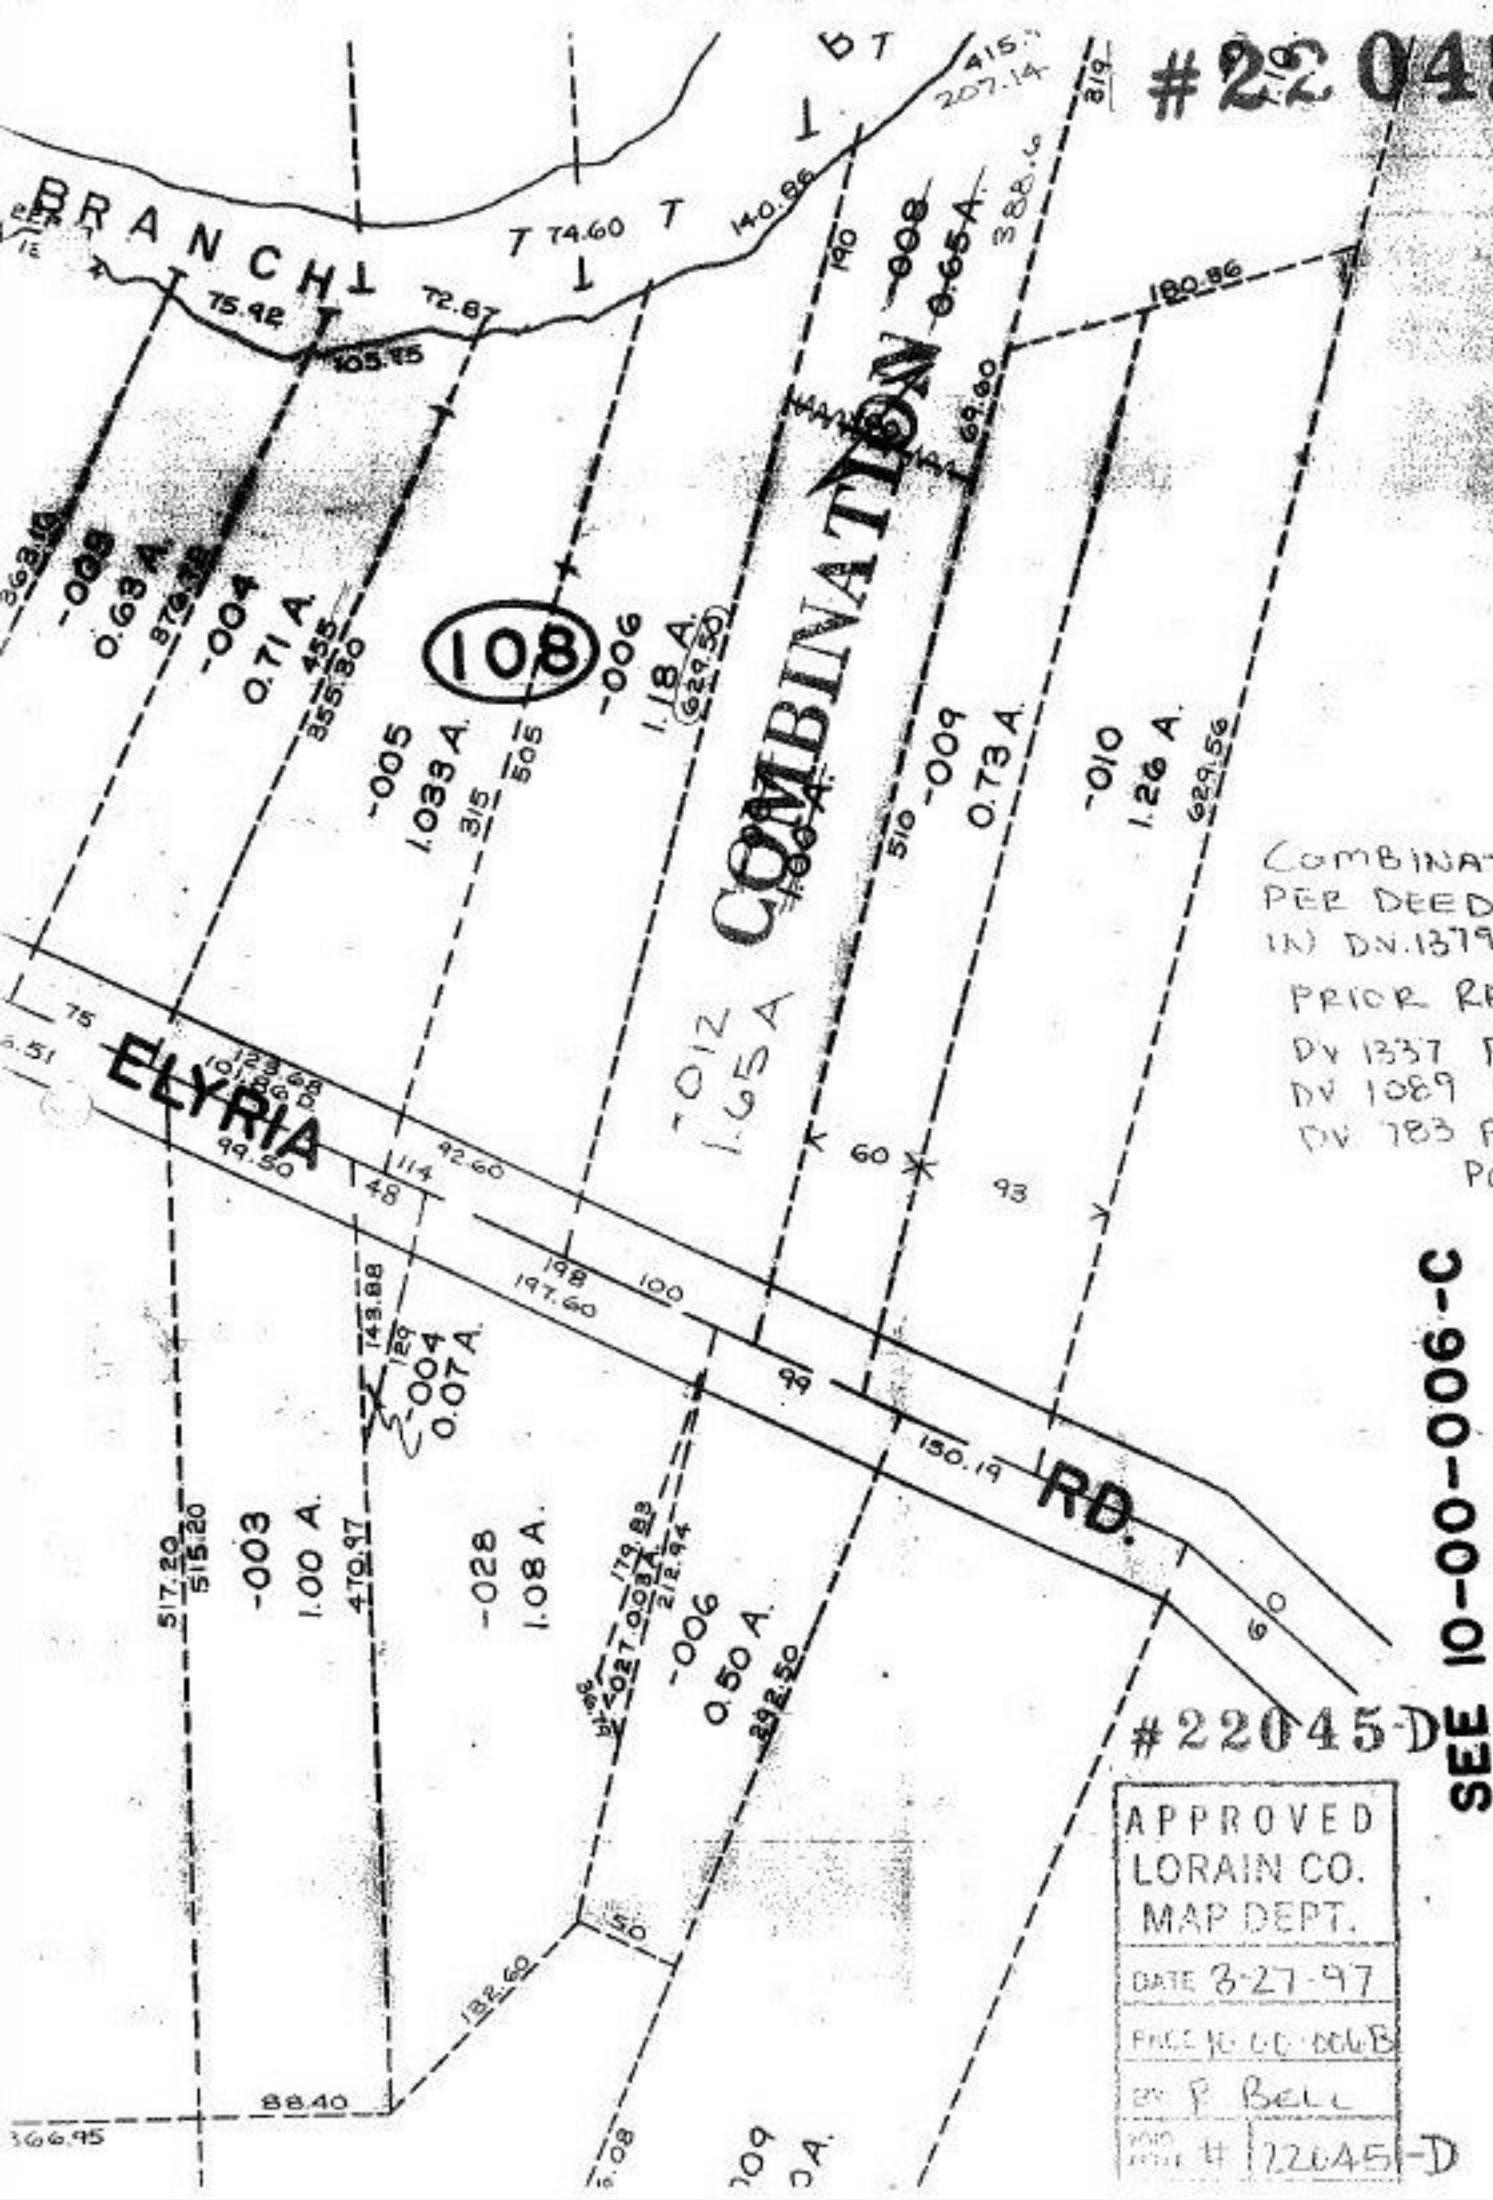

COMBINATION
PER DEED REC.
IN DN 1379 P. 434

PRIOR REF:

DV 1337 P. 503
DV 1089 P. 698
DV 783 P. 180
P.C. #3

SEE 10-00-006-C

#22045
APPROVED
LORAIN CO.
MAP DEPT.

DATE 3-27-97

FREIGHT CARRIERS

228 P. Bely