
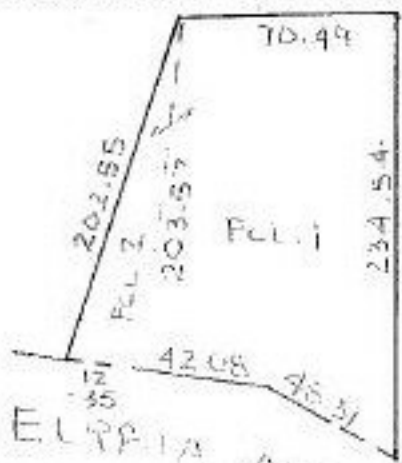


#22046-D

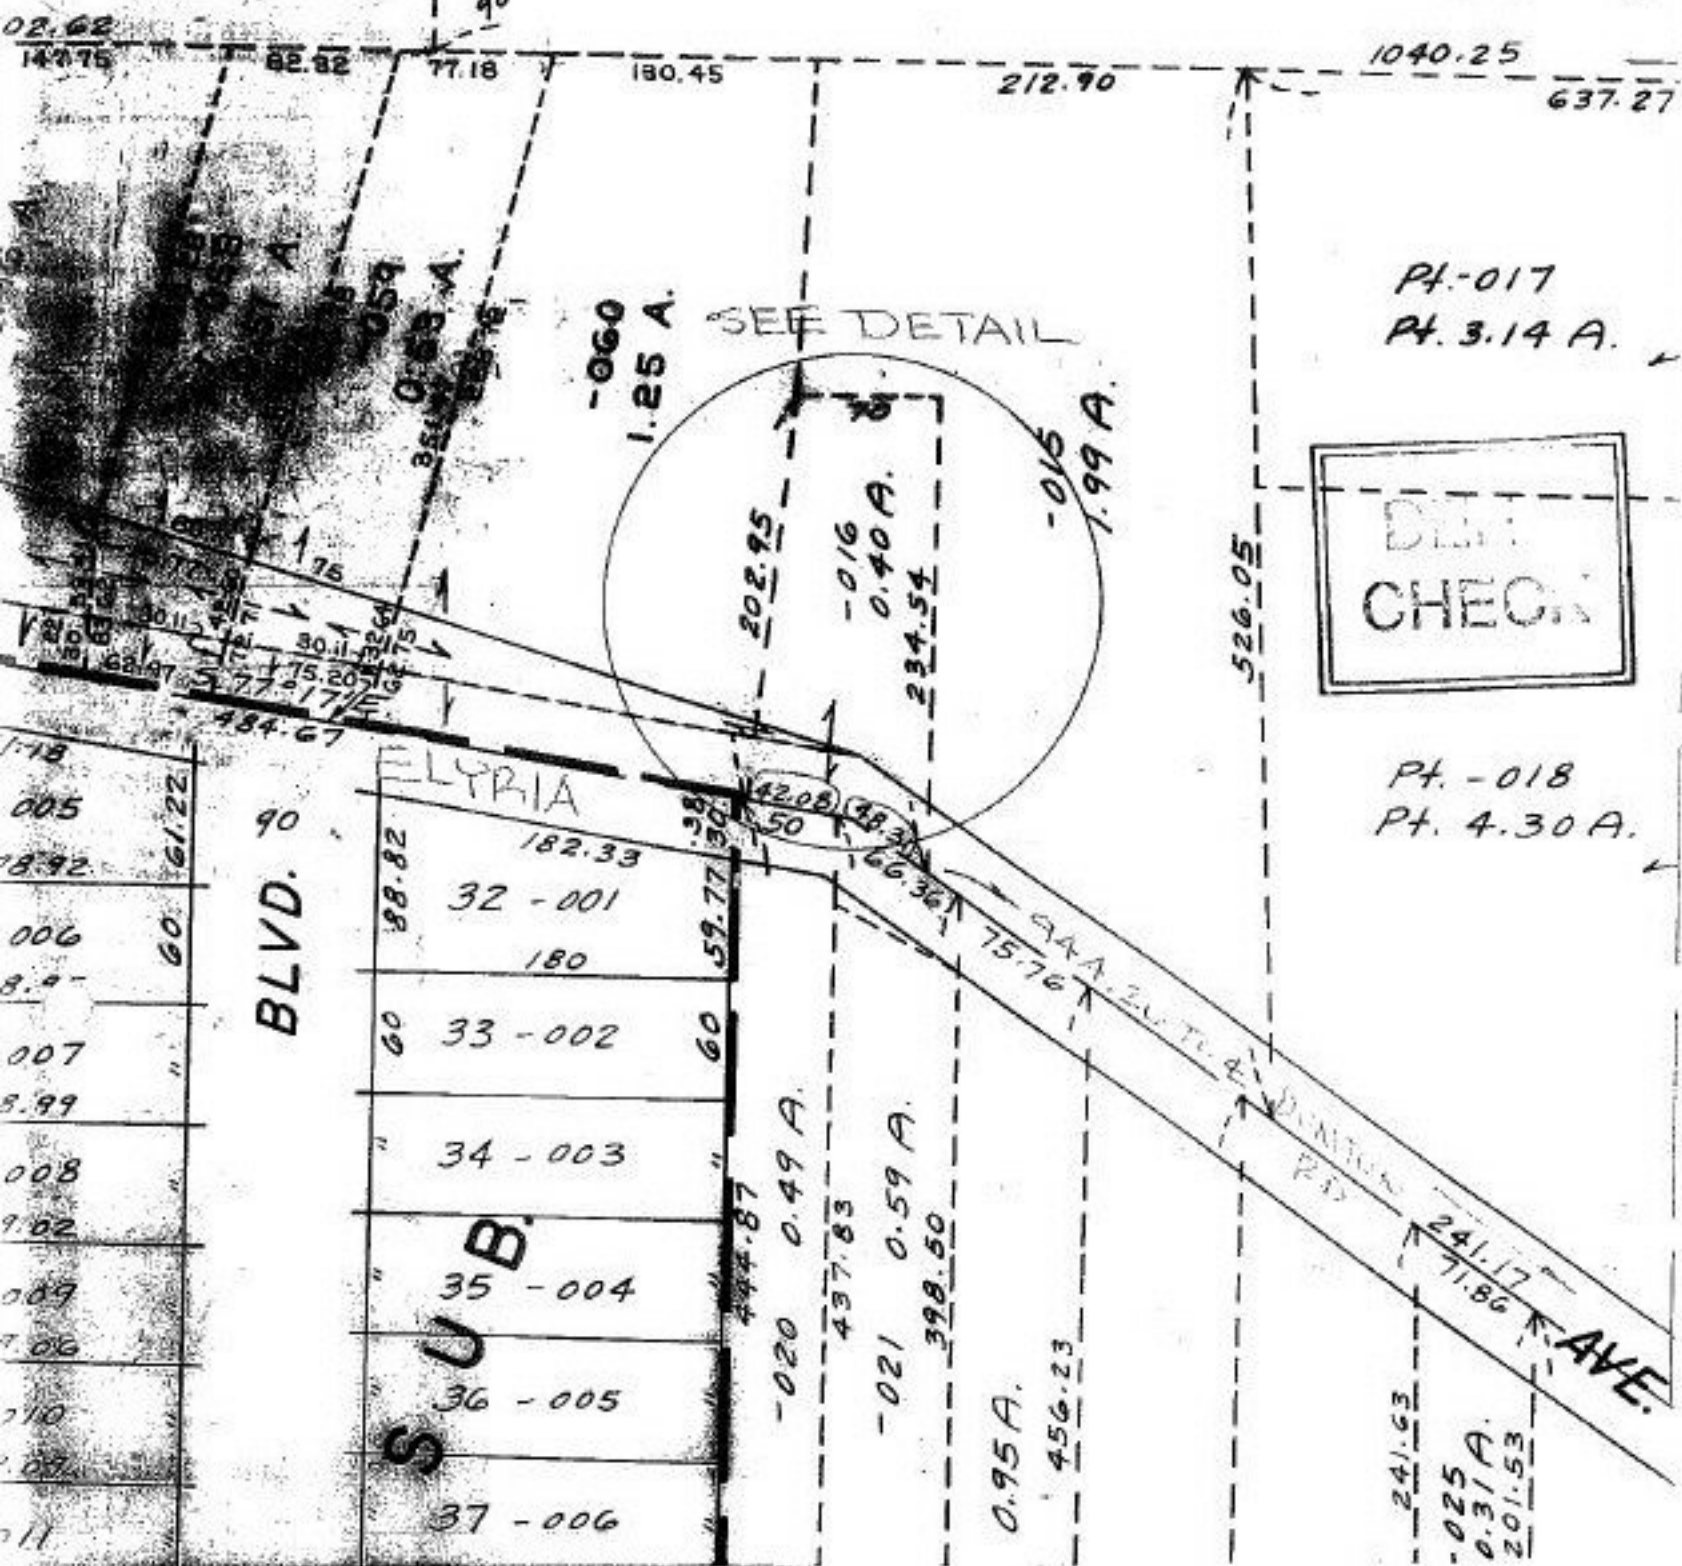

SURVEY BY  
C.E. PENFOLD  
REC. IN D.V. 834  
P. 157

MAP CORRECTION  
ONLY

22046-D

APPROVED  
LORAIN CO.  
MAP DEPT.

DATE 2-14-97

PAGE 3 OF 10 TA

BY R. BELL

MAP # 22046-D