


#22046

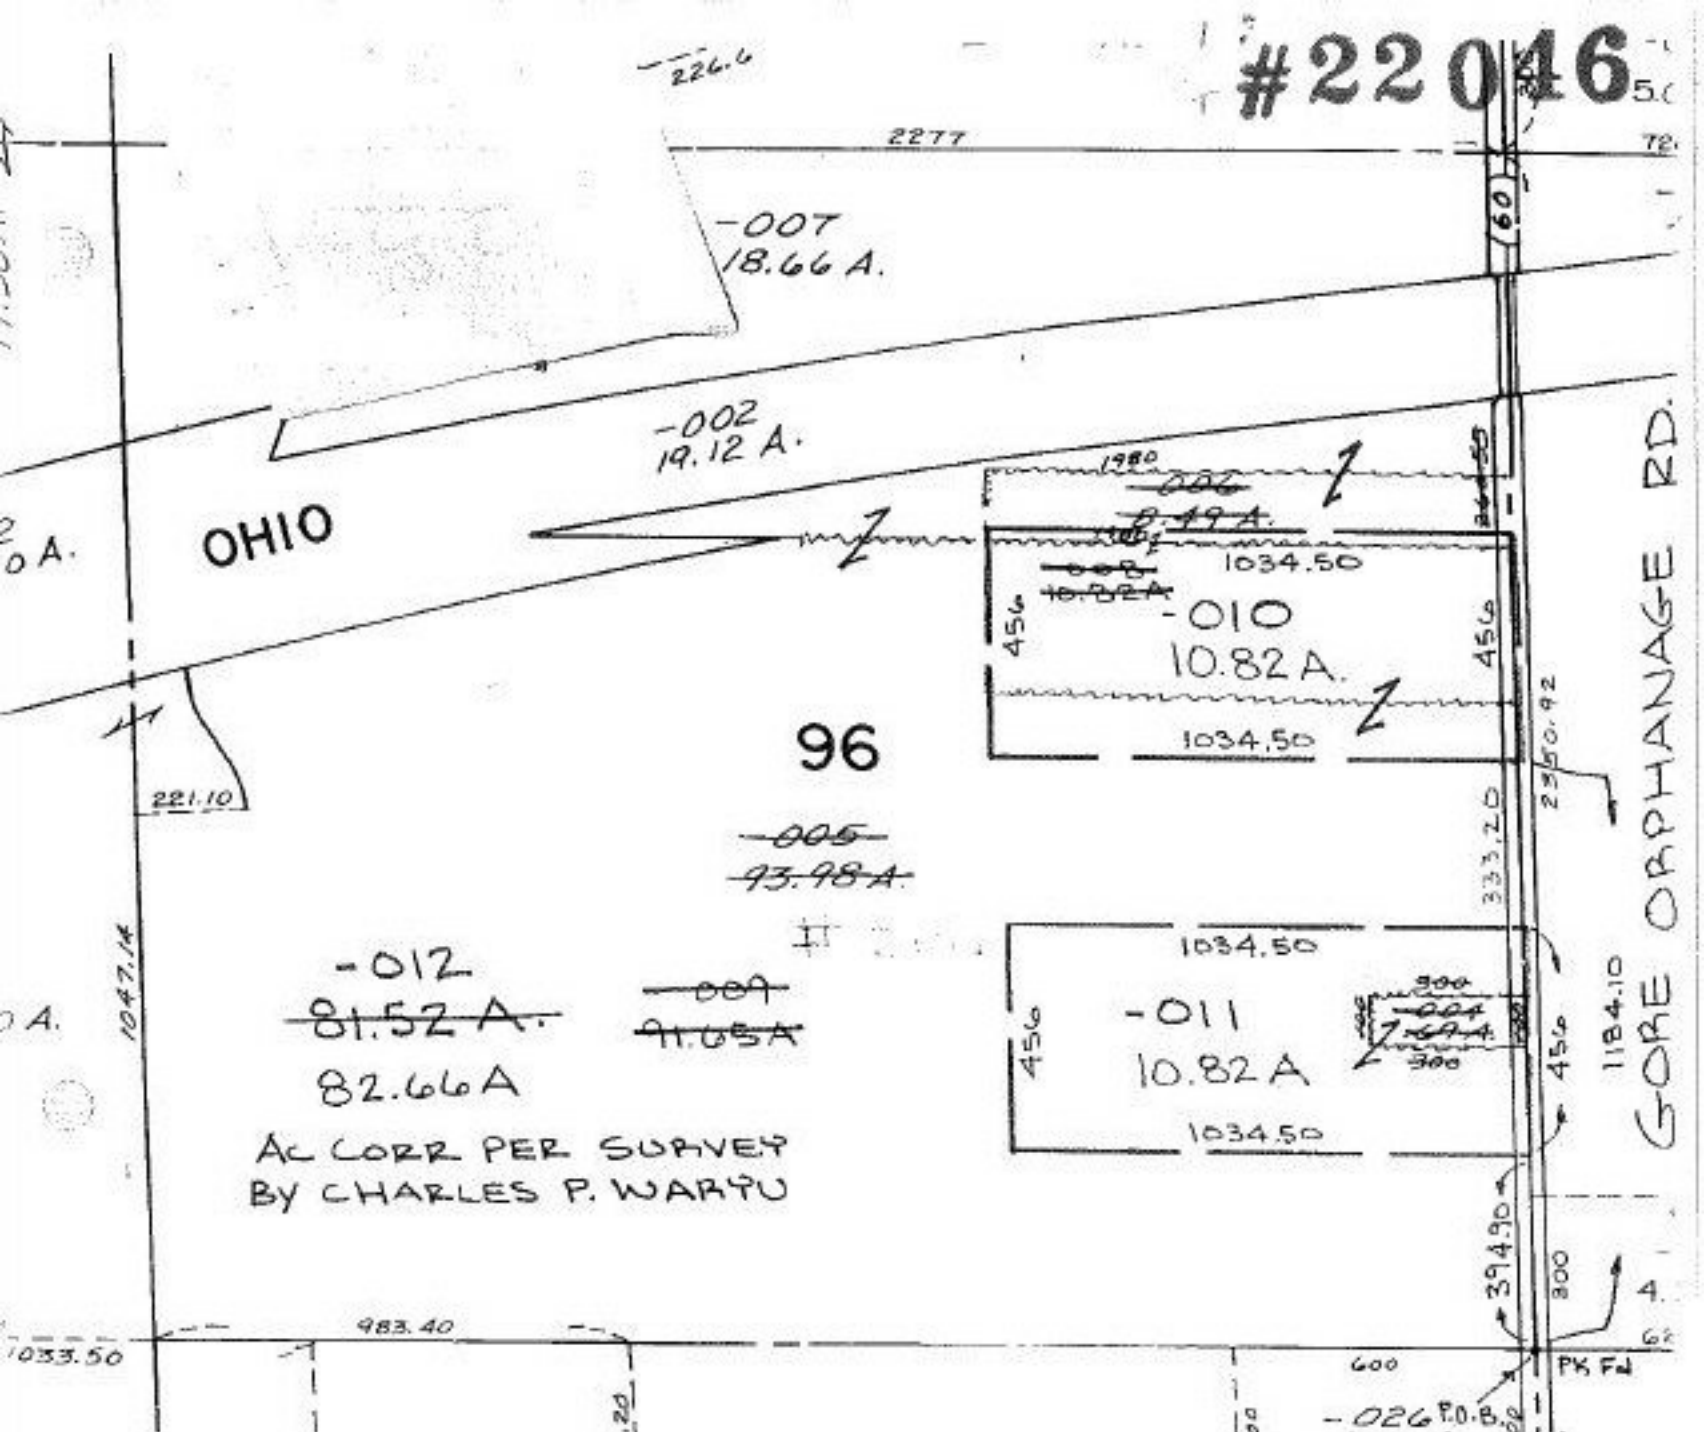

22046

APPROVED	
LORAIN CO.	
MAP DEPT.	
DATE 1-20-97	
PAGE B-A	
BY R. BELL	
MAP	# 22046