



RD. PARSONS

RD.

#22052
SEE
DETAIL

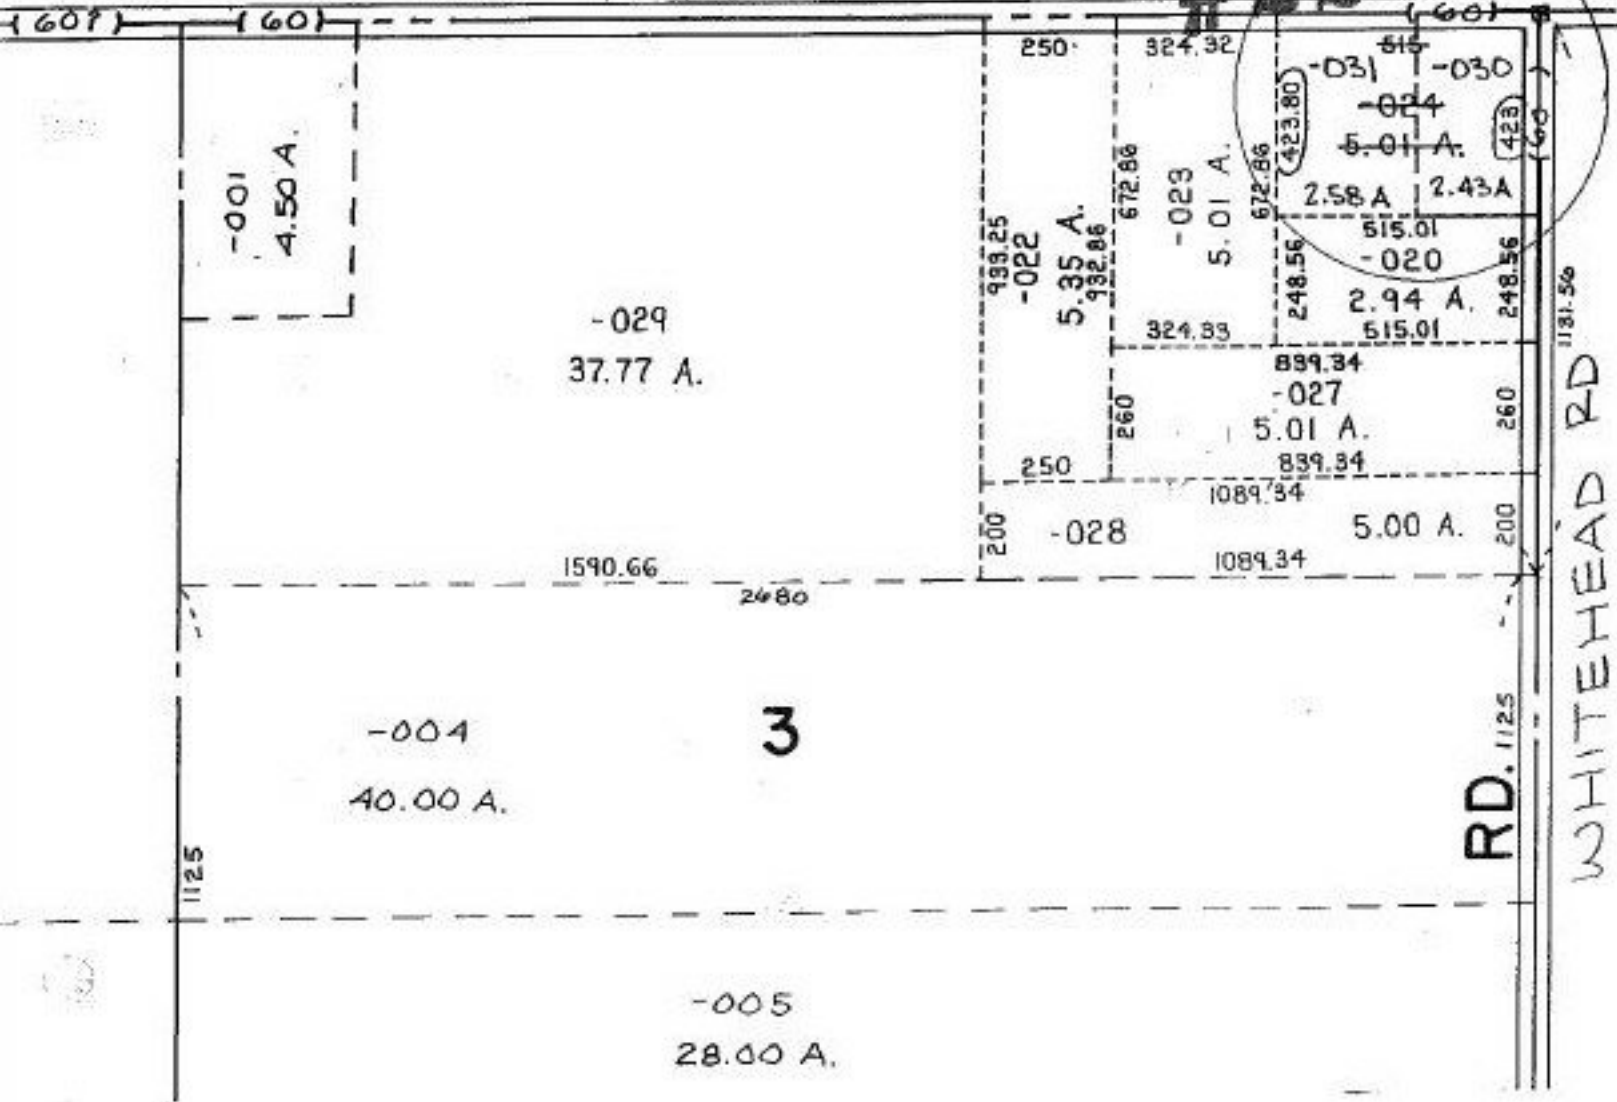

PARSONS RD

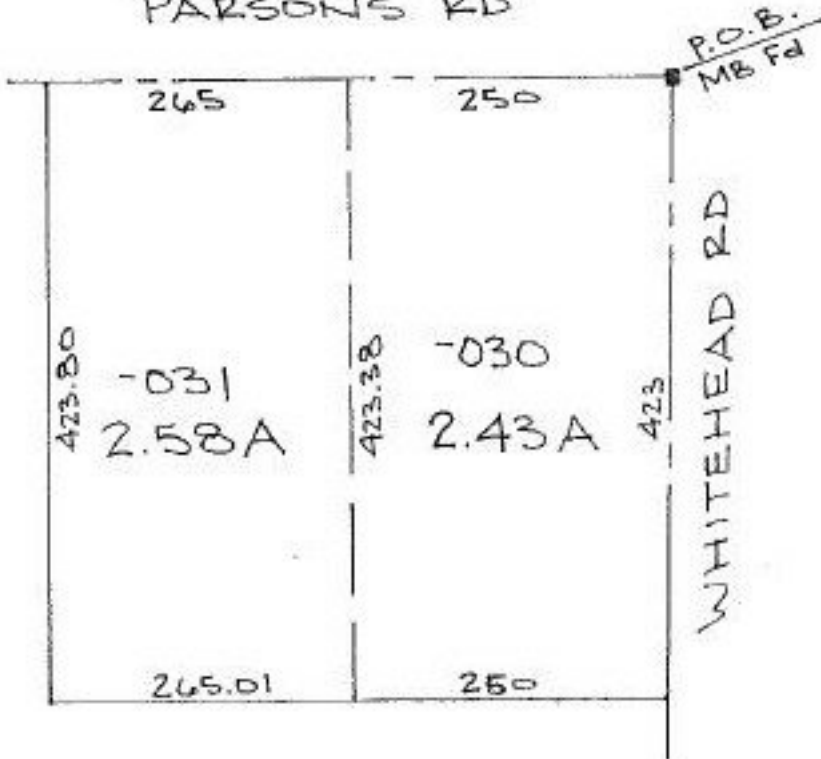

DETAIL NO SCALE

RD. 1125
WHITEHEAD RD

22052

APPROVED LORAIN CO. MAP DEPT.	
DATE 1-28-97	
PAGE 15-A	
BY P. BELL	
VOID AFTER #	22052